


# AS BUILT

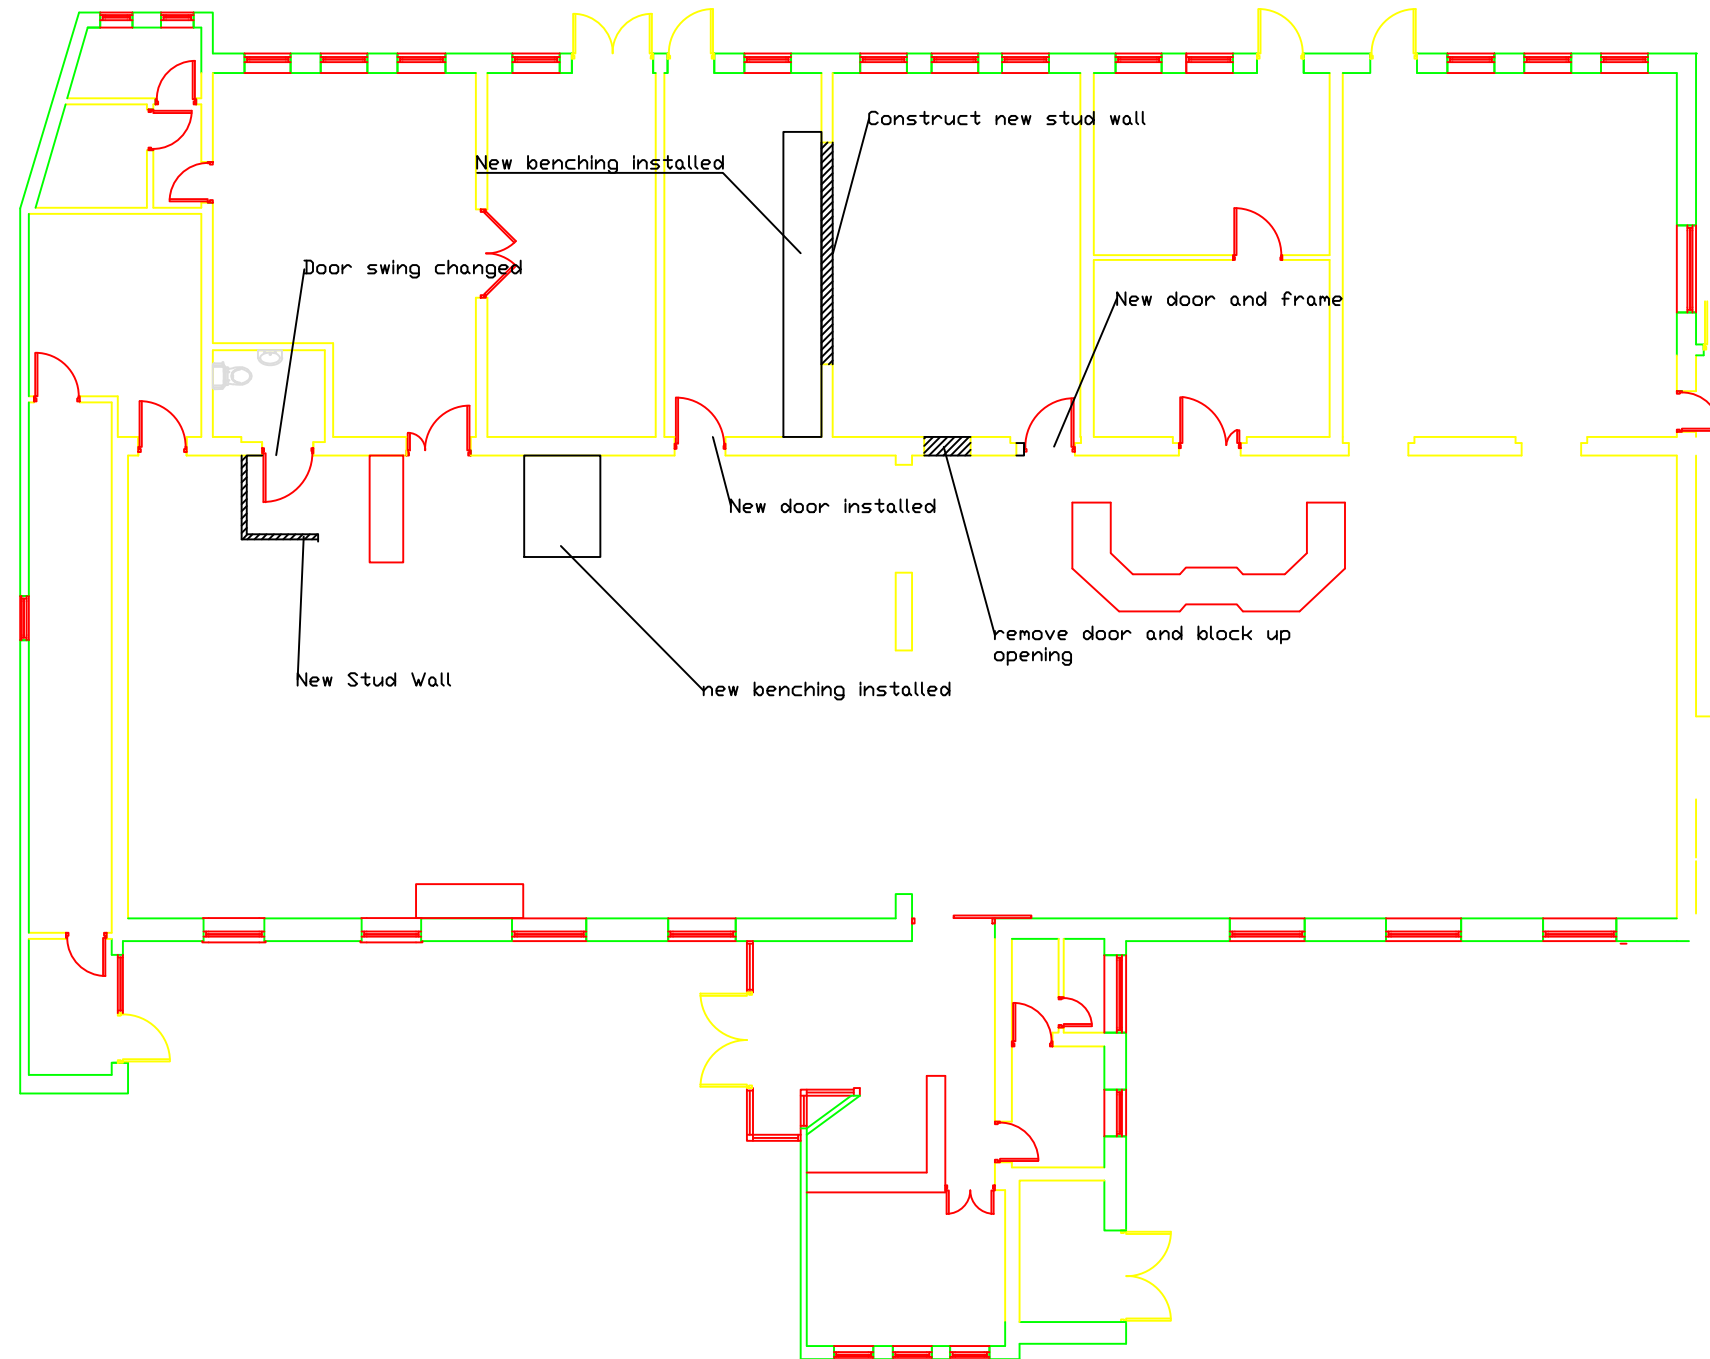

INVESTOR IN PEOPLE



**Leicestershire  
County Council**

CLIENT ---

PROJECT AS BUILT PLAN  
FOR WEBSITE  
UPDATE  
---

scale	drawn	checked	
N.T.S	---	---	A3
job no.	date	drawing no.	rev.
---	---	CM/	0
COUNTY HALL • GLENFIELD • LEICESTER • LE3 8RE			
propertyhelpdesk@leics.gov.uk Tel (0116) 305 • Fax 305			