

**Definitive Map of Rights of Way for Leicestershire**
**Register of Definitive Map Modification Order Applications**

Short Description: <b>Add a footpath along Bottleacre Lane from Pavilion Way to the Western power Substation</b>				
Application No.:	<b>M1101</b>	Legal Services Ref. No.:		
Application Status:	<b>Application and UE forms received</b>			
Geographical Location				
Path No:		Route name (if known):	<b>Bottleacre Lane</b>	
Settlement:	<b>Loughborough</b>			
Parish:	<b>Loughborough</b>			
District/Borough:	<b>Charnwood BC</b>			
Nearest Town/City:	<b>Loughborough</b>			
Start Location:	<b>Pavilion Way</b>			
Start Grid Refs:	Landranger:	<b>SK 533 209</b>	Eastings,Northings:	<b>45338,32093</b>
End Location:	<b>Substation</b>			
End Grid Refs:	Landranger:	<b>SK 533 212</b>	Eastings,Northings:	<b>45338,32122</b>
Applicant's Name, Address & Postcode: <b>D Jarram, 130 Bottleacre Lane, Loughborough, Leicestershire, LE11 1JQ</b>				
Date Received:	<b>19/04/2017</b>		Date Determined:*	
Application Stage(s): • Research				
For Further Information				
Case Officer:	<b>Stephen Tipping</b>			
Telephone:	<b>0116 305 7084</b>			
Email:	<b>footpaths@leics.gov.uk</b>			
Contents List:				Page:
<b>Application Form</b>				<b>2 - 3</b>
<b>Map accompanying the application</b>				<b>4</b>
<b>Additional Documents</b>				
<b>Inspector's Decision</b>				

\* Note the **Determination Date** is the occasion on which Leicestershire County Council formally decided whether or not to make an order in response to this application.

**APPLICATION FOR DEFINITIVE MAP MODIFICATION ORDER**

WILDLIFE AND COUNTRYSIDE ACT 1981  
DEFINITIVE MAP AND STATEMENT FOR THE COUNTY OF LEICESTERSHIRE

Please complete this form and return it together with Form PT636, and any evidence you wish to submit, to: Safe and Sustainable Travel Team, Environment and Transport Department, Leicestershire County Council, County Hall, Glenfield, Leicester, LE3 8RJ.

I/We THE RESIDENTS of BOTTLE ACRE CANY  
of WALTHAMPTON

hereby apply for an Order under Section 53(2) of the Wildlife and Countryside Act 1981, modifying the Definitive Map and Statement for the area by

\*adding a footpath/bridleway/byway open to all traffic

\*~~deleting a footpath/bridleway/byway open to all traffic~~

\*~~upgrading the footpath/bridleway~~

\*~~downgrading the bridleway/byway open to all traffic~~

\*~~varying the particulars in the Definitive Statement relating to the footpath/bridleway/byway open to all traffic~~

(\*delete as appropriate)

which runs from BOTTLE ACRE CANY / JOBECK DRIVE  
to WESTERN RAIL SUB STATION

as shown on the attached plan.

I/We attach copies of the following documentary evidence (including statements of witnesses) in support of this application:

List of Documents

WITNESS STATEMENTS (INCLUDING MAPS)  
✓ ARIUS ORDANCE SURVEY MAPS VIA EMAIL

Signed [Signature] Dated 17/4/17

**How we use your information**

Any information you provide will be used in accordance with the Data Protection Act 1998 and other relevant legislation. The information will be used to consider your application for a Definitive Map Modification Order. A copy of your application (including your name and address) will be published online in order to meet statutory requirements. Other personal details (such as telephone numbers, email addresses and signatures) will be removed before publication.

**CERTIFICATE OF SERVICE OF NOTICE:**

**APPLICATION FOR DEFINITIVE MAP MODIFICATION ORDER**

WILDLIFE AND COUNTRYSIDE ACT 1981

DEFINITIVE MAP AND STATEMENT FOR THE COUNTY OF LEICESTERSHIRE

Please complete this form and return it together with Form PT634, and any evidence you wish to submit, to: Safe and Sustainable Travel Team, Environment and Transport Department, Leicestershire County Council, County Hall, Glenfield, Leicester, LE3 8RJ.

I/We, THE RESIDENTS  
of BOTTLE ACRE LANE WOODBOROUGH

Hereby certify that the requirements of paragraph 2 of Schedule 14 of the Wildlife and Countryside Act 1981, have been complied with.

Names and addresses of owners and occupiers of land on whom Notice has been served

R+2 MOTOS, BOTTLE ACRE LANE, WOODBOROUGH

WESTERN POWER DISTRIBUTION, PEARSONS BUSINESS  
PARK, HIGGINS WAY, CASTLE DONINGTON, RUGBY, DE 74 2 7U

GREEN TRAM WALK LTD, HALLS LANE, NEWTHORP,  
NG16 2DE

Signed [Signature] Dated 17/4/19



E.6.5.

Leicestershire County Council

Bottleacre Lane

Location Plan



Name

DEBBIE JACKMAN


Signature

Environment & Transport Department,  
County Hall, Glenfield,  
Leicestershire LE3 8RJ  
email [footpaths@leics.gov.uk](mailto:footpaths@leics.gov.uk)  
Director Phil Crossland



Plan No. 1P

Scale 1:3500

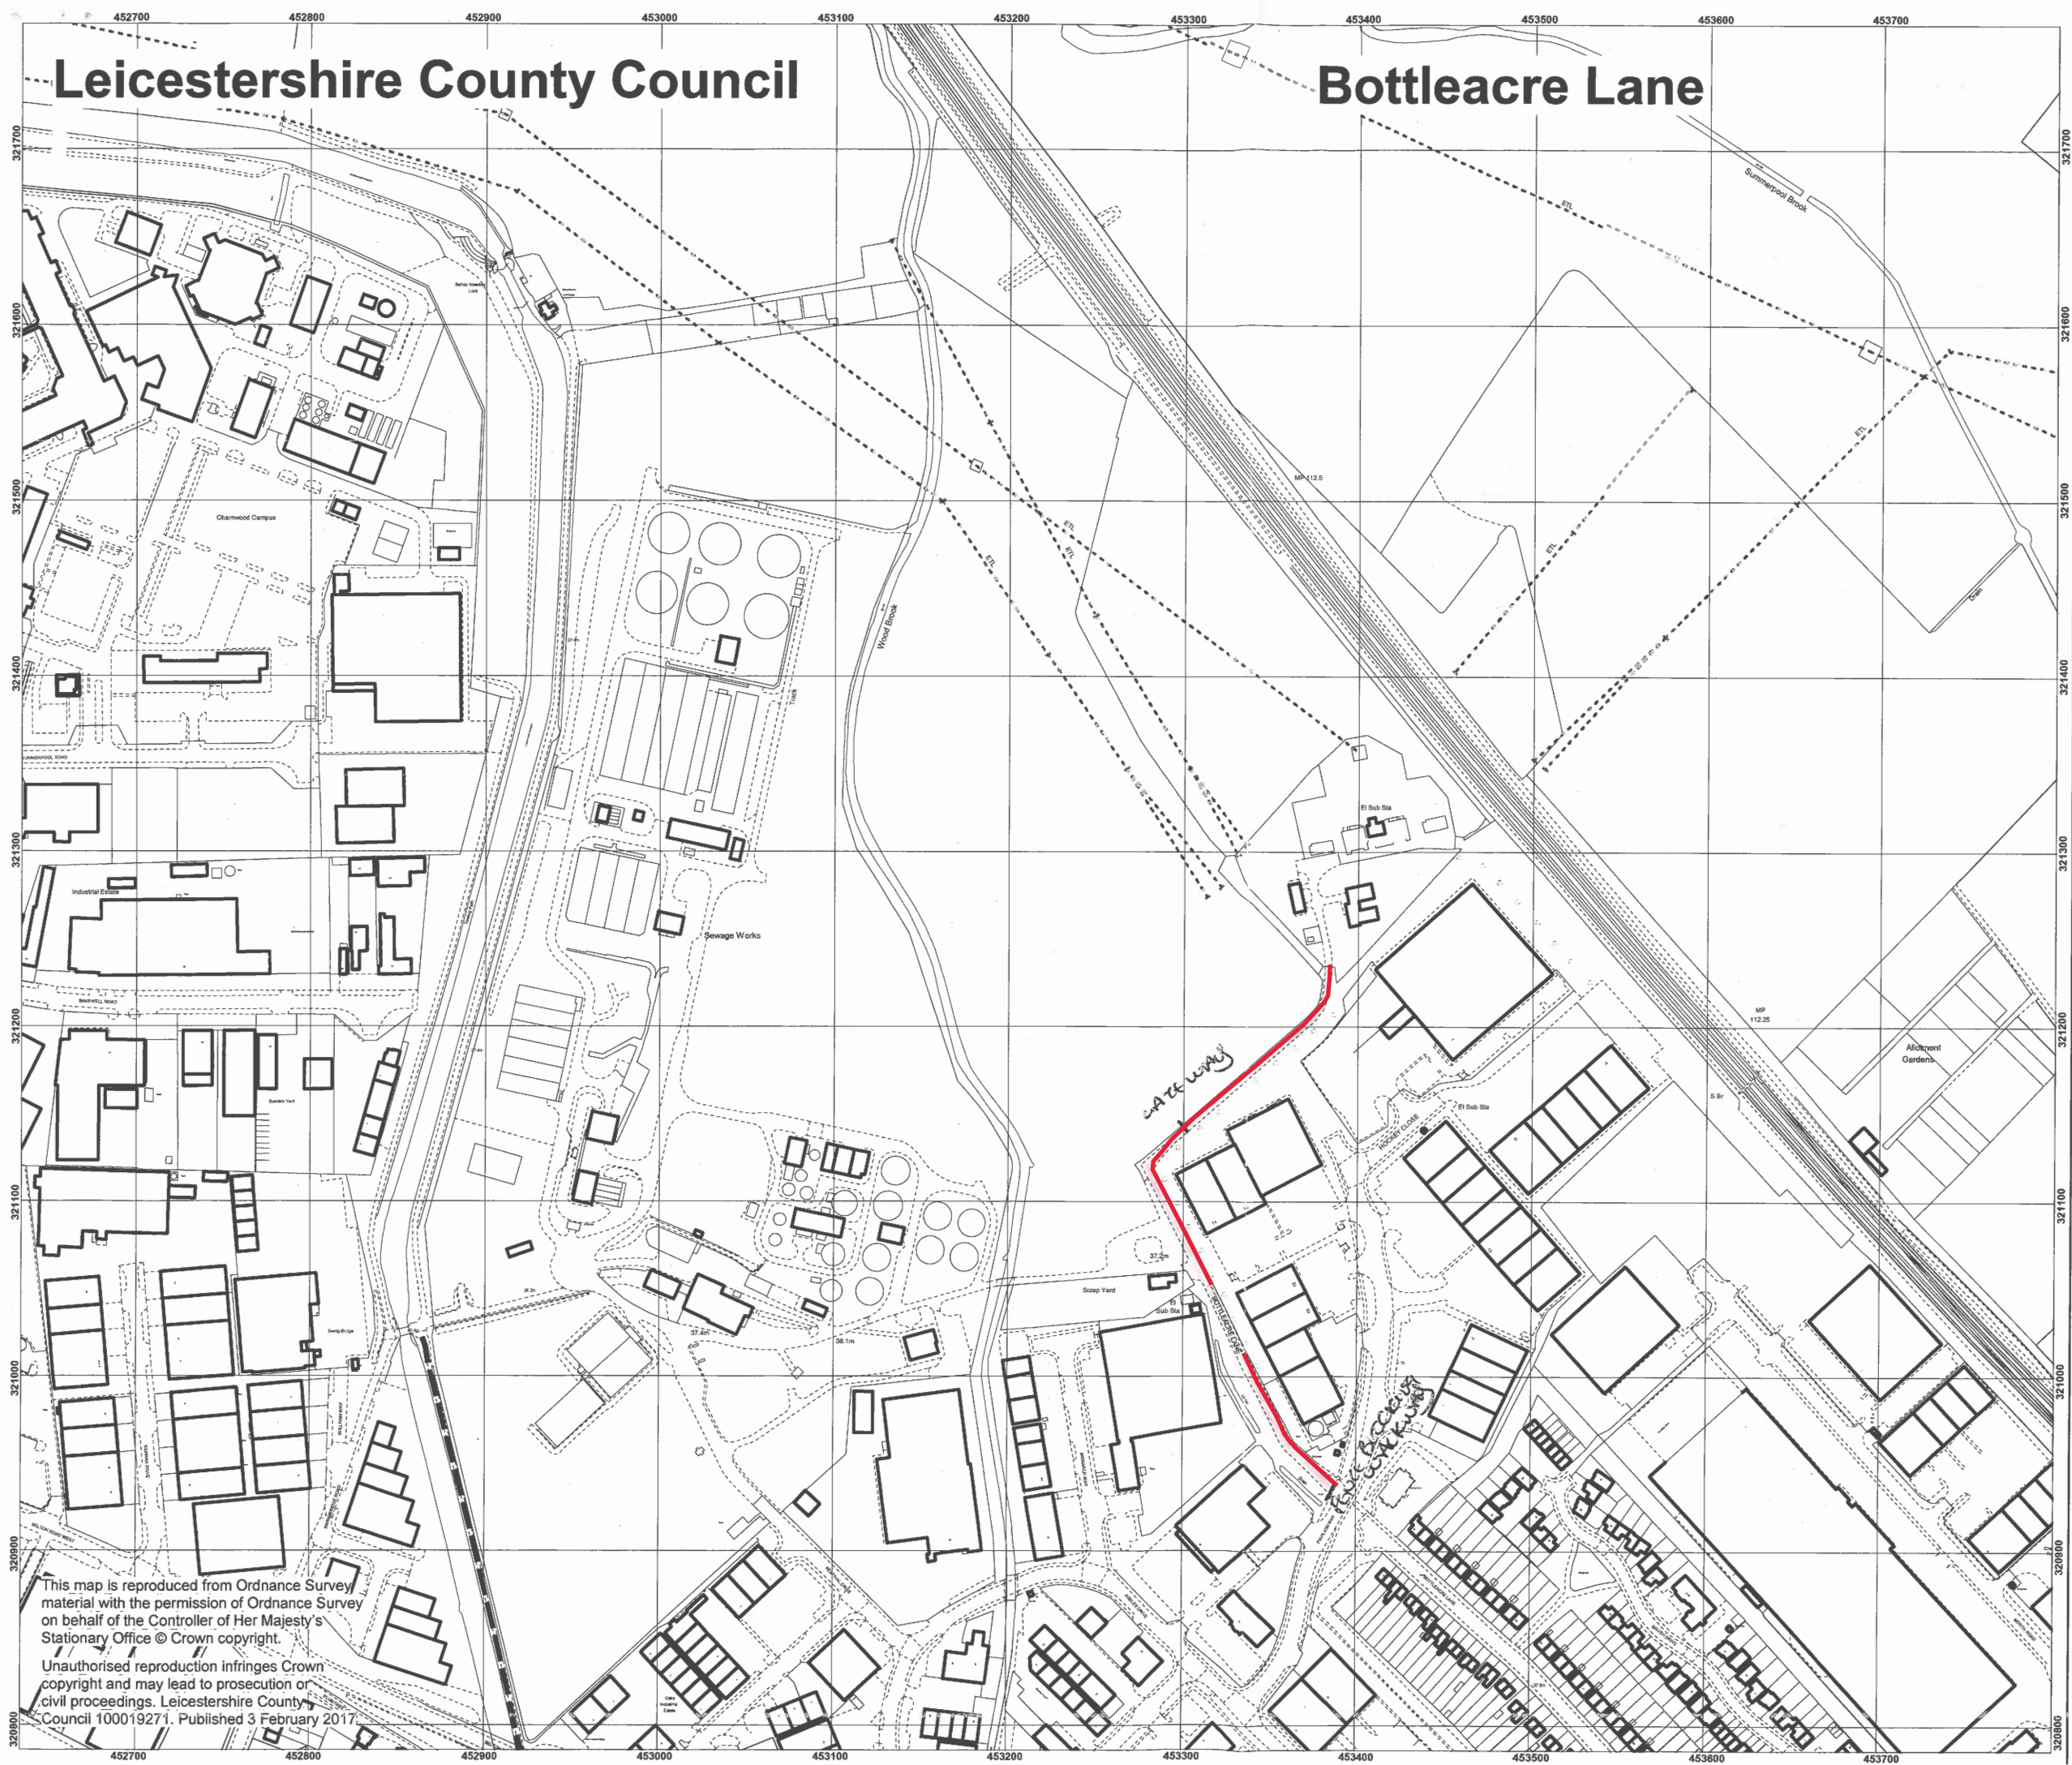

This map is reproduced from Ordnance Survey material with the permission of Ordnance Survey on behalf of the Controller of Her Majesty's Stationary Office © Crown copyright.  
Unauthorised reproduction infringes Crown copyright and may lead to prosecution or civil proceedings. Leicestershire County Council 100019271. Published 3 February 2017.