

Definitive Map of Rights of Way for Leicestershire Register of Definitive Map Modification Order Applications

Short Description: Upgrade the footpath (F18) between Bridleway F28 and the Parish Boundary at Goadby Marwood (evidence of use)			
Application No.:	M1226	Legal Services Ref. No.:	
Application Status:	Bridleway		
Geographical Location			
Path No:	F18	Route name (if known):	
Settlement:	Goadby Marwood		
Parish:	Eaton		
District/Borough:	Melton BC		
Nearest Town/City:	Melton Mowbray		
Start Location:	Bridleway F28, Goadby Marwood		
Start Grid Refs:	Landranger:	SK 772 261	Eastings,Northings: 477250,326120
End Location:	Bridleway F18, at the Eaton/Scalford Parish Boundary		
End Grid Refs:	Landranger:	SK 772 257	Eastings,Northings: 477240,325780
Applicant's Name, Address & Postcode: Leicestershire and Rutland Bridleways Association C/o 123 Park Road, Loughborough LE11 2HD			
Date Received:	17/03/2021	Date Determined:*	
Application Stage(s): <ul style="list-style-type: none"> • Under preliminary investigation by Leicestershire County 			
For Further Information			
Case Officer:	Ellen Senior		
Telephone:	0116 305 7085		
Email:	footpaths@leics.gov.uk		
Contents List:			Page:
Application Form			1
Map accompanying the application			2

* Note the **Determination Date** is the occasion on which Leicestershire County Council formally decided whether or not to make an order in response to this application.

APPLICATION FOR DEFINITIVE MAP MODIFICATION ORDER

WILDLIFE AND COUNTRYSIDE ACT 1981
DEFINITIVE MAP AND STATEMENT FOR THE COUNTY OF LEICESTERSHIRE

Please complete this form and return it together with Form PT636, and any evidence you wish to submit, to: Safe and Sustainable Travel Team, Environment and Transport Department, Leicestershire County Council, County Hall, Glenfield, Leicester, LE3 8RJ.

I/We.....**Leicestershire & Rutland Bridleways Association**.....
of.....**c/o 123 Park Road, Loughborough, Leics, LE11 2HD**

hereby apply for an Order under Section 53(2) of the Wildlife and Countryside Act 1981, modifying the Definitive Map and Statement for the area by

~~*adding a footpath/bridleway/byway open to all traffic~~

~~*deleting a footpath/bridleway/byway open to all traffic~~

*upgrading the footpath/bridleway- **F18 in the parish of Eaton**

~~*downgrading the bridleway/byway open to all traffic~~

~~*varying the particulars in the Definitive Statement relating to the footpath/bridleway/byway open to all traffic~~

(*delete as appropriate)

which runs from.....**Bridleway F18 at the parish boundary with Scalford**.....
to.....**its junction with bridleway F28 which runs W from Goadby Marwood to the Scalford-Eaton road**.....


as shown on the attached plan.

I/We attach copies of the following documentary evidence (including statements of witnesses) in support of this application:

List of Documents

.....**25 Evidence of Use Forms**.....
.....plus 6 which are not 100% correctly completed.....

.....
.....
.....

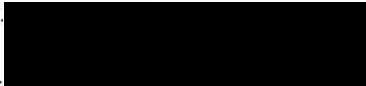
Signed.......... Dated... **17 March 2021**.....
pp Leics & Rutland Bridleways Association

How we use your information
Any information you provide will be used in accordance with current data protection regulations and other relevant legislation. The information will be used to consider your application for a Definitive Map Modification Order. A copy of your application (including your name and address) will be published online in order to meet statutory requirements. Other personal details (such as telephone numbers, email addresses and signatures) will be removed before publication.

Based on The Definitive Map of Public Rights of Way for Leicestershire

Compiled on 16 November 2020 Scale 1:5000

Environment & Transport Department,
County Hall, Glenfield,
Leicestershire LE5 8PJ
email: footpaths@leics.gov.uk
Director Ann Carruthers

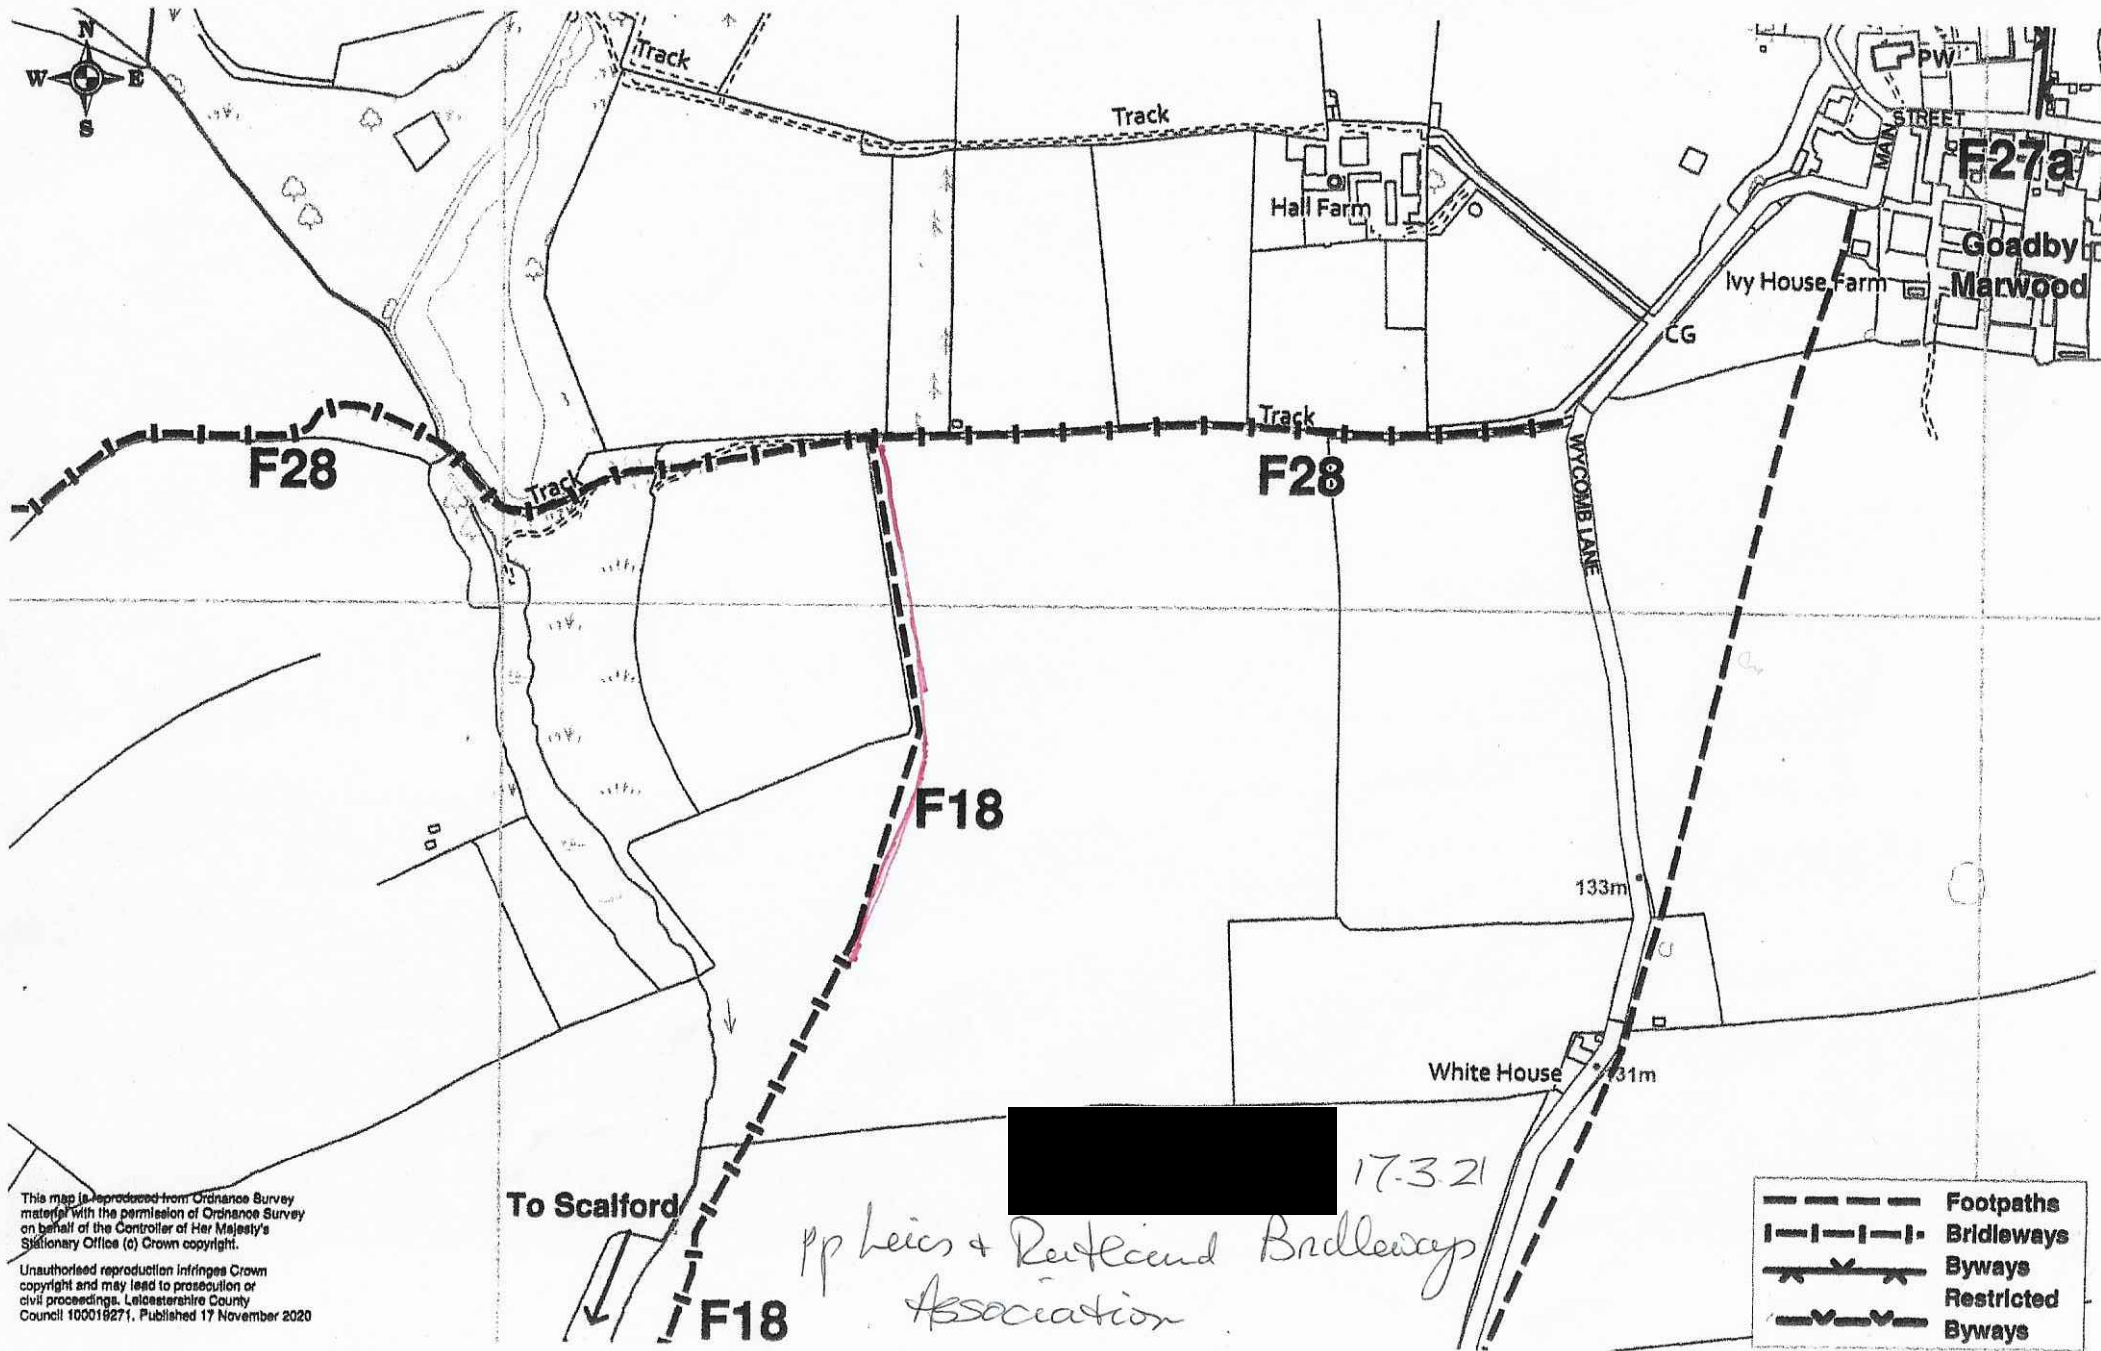

This map is reproduced from Ordnance Survey material with the permission of Ordnance Survey on behalf of the Controller of Her Majesty's Stationary Office (c) Crown copyright.

Unauthorized reproduction infringes Crown copyright and may lead to prosecution or civil proceedings. Leicestershire County Council 100018271. Published 17 November 2020

To Scalford

pp Leics + Rutland Bridleways Association

- Footpaths
- Bridleways
- Byways
- Restricted Byways