

THE LEICESTERSHIRE COUNTY COUNCIL (LOUGHBOROUGH, CHARNWOOD
BOROUGH) CONSOLIDATION ORDER 2022 (VARIOUS ROADS, LOUGHBOROUGH)
(AMENDMENT 2) ORDER 202

THE LEICESTERSHIRE COUNTY COUNCIL hereby gives notice that it proposes to make an Order under Sections 1, 2, 4, 5, 19, 32, 35, 45, 46, 47, 49 and Part IV of Schedule 9 of the Road Traffic Regulation Act 1984 ("the Act"), and of all other enabling powers, and after consultation with the Chief Officer of Police in accordance with Part III of Schedule 9 to the Act, the effect of which will be:

1. To revoke Disabled Parking Bays on parts of Cambridge Street, Cartwright Street, Herbert Street, Howard Street and Sparrow Hill, Loughborough
2. To impose Residents Parking Bays on parts of Cambridge Street, Cartwright Street, Herbert Street, Howard Street and Sparrow Hill, Loughborough
3. To impose Mandatory Disabled Parking Bays on parts of Glebe Street, Limehurst Avenue and Ratcliffe Road, Loughborough
4. To impose Limited Waiting for 2 hours with No Return within 1 hour from Monday to Saturday between 8am and 6pm on part of Sparrow Hill, Loughborough

A copy of the proposed Order, together with a plan illustrating the proposals and an explanatory statement giving the Council's reasons for proposing to make the Order may be inspected during normal office hours at my offices, Room 200, County Hall, Glenfield, Leicester LE3 8RA or at the offices of Charnwood Borough Council, Southfield Rd, Loughborough LE11 2TX


Documents can also be viewed online at <https://www.leicestershire.gov.uk/roads-and-travel/cars-and-parking/traffic-management-consultations>

Objections to the proposals, specifying the grounds on which they are made, should be sent in writing to the undersigned by not later than 29th March 2023, quoting reference KJ/HTWMT/5433. Alternatively, objections can be emailed to kevin.jukes@leics.gov.uk or via the online comment form which may be accessed via the link above. If you require alternative formats of this Notice, including larger print, braille or fax transmission, please contact Leicestershire County Council on (0116) 305 0001.



Dated: 8th March 2023

Lauren Haslam, Director of Law and Governance, Leicestershire County Council, County Hall, Glenfield, Leicester LE3 8RA

KEY

 **RESIDENTS PERMIT
HOLDER PARKING ZONE 8
OR LIMITED WAITING FOR
1 HOUR NO RETURN
WITHIN 1 HOUR MON - SAT
8AM TO 6PM
REVOCATION OF EXISTING
MANDATORY DISABLED
PERSONS PARKING BAY**

 **EXISTING RESTRICTIONS**

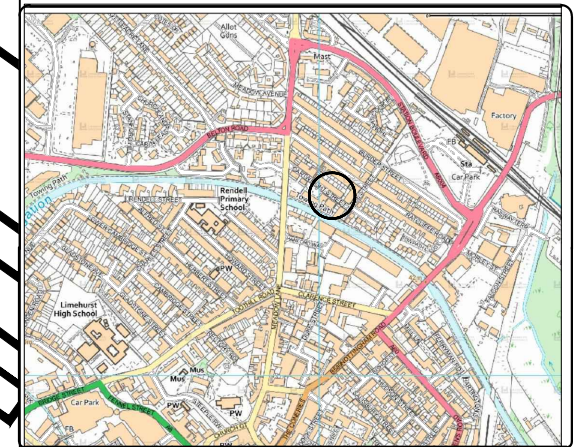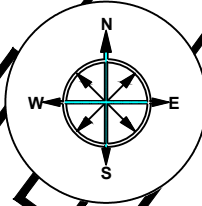

**ENVIRONMENT AND
TRANSPORT DEPARTMENT**

**ANN CARRUTHERS
DIRECTOR**

**TRAFFIC AND SIGNALS
NETWORK MANAGEMENT**

LOUGHBOROUGH

TITLE:

**REVOCATION OF MANDATORY 24 HOUR
DISABLED PARKING BAY
45 CARTWRIGHT STREET**

DRAWING NUMBER

TM5080/T1/1/45CARTWRIGHT

PREPARED BY:

LEE MEASURES

CHECKED BY:

RIZWAN SHARIF

APPROVED BY:

GAVIN NEAT

SCALE

NTS

DATE: 17/01/2023

SIZE : A4

COUNTY HALL * GLENFIELD * LEICESTER * LE3 8ST

Tel: 0116 3050001 * Fax: 0116 3050006

E-Mail address:

customerservices@leics.gov.uk

Website:

www.leicestershire.gov.uk

MAPINFO (C) Leicestershire County Council



© Crown copyright. All rights reserved. Leicestershire County Council 100019271
Published 2023.



**Leicestershire
County Council**

KEY

- RESIDENTS PERMIT HOLDER
PARKING ONLY ZONE 8
REVOCATION OF EXISTING
MANDATORY DISABLED
PERSONS PARKING BAY
- EXISTING MANDATORY DISABLED
PERSONS PARKING BAY
- OTHER EXISTING RESTRICTIONS

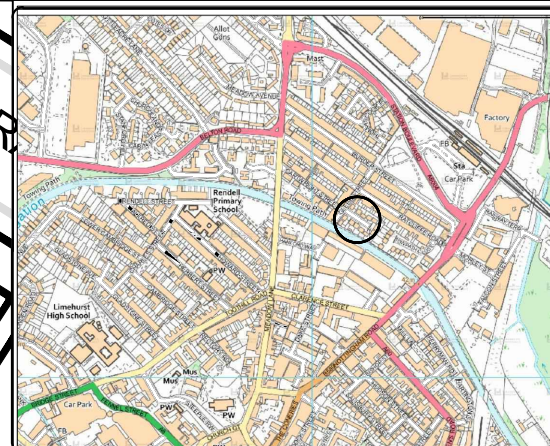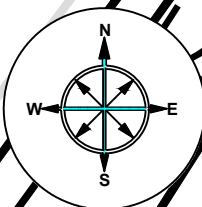

ENVIRONMENT AND
TRANSPORT DEPARTMENT

ANN CARRUTHERS
DIRECTOR

TRAFFIC AND SIGNALS
NETWORK MANAGEMENT

LOUGHBOROUGH

TITLE:
REVOCATION OF MANDATORY 24 HOUR
DISABLED PARKING BAY
63 CARTWRIGHT STREET

DRAWING NUMBER	SCALE
TM5080/T1/1/63CARTWRIGHT	NTS
PREPARED BY: LEE MEASURES	
CHECKED BY: RIZWAN SHARIF	DATE: 16/11/2022
APPROVED BY: GAVIN NEAT	SIZE: A4

COUNTY HALL * GLENFIELD * LEICESTER * LE3 8ST

Tel: 0116 3050001 * Fax: 0116 3050006

E-Mail address: customerservices@leics.gov.uk
Website: www.leicestershire.gov.uk

MAPINFO (C) Leicestershire County Council
© Crown copyright. All rights reserved. Leicestershire County Council 100019271
Published 2023.



KEY




**PROPOSED MANDATORY
DISABLED PERSONS
PARKING BAY**

**EXISTING RESIDENTS
PERMIT HOLDER PARKING
ZONE 8 OR LIMITED
WAITING FOR 1 HOUR NO
RETURN WITHIN 1 HOUR
MON - SAT 8AM TO 6PM**




EXISTING RESTRICTIONS

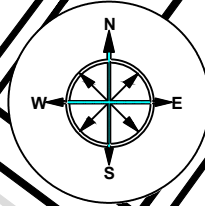

CARTWRIGHT STREET

GLEBE STREET

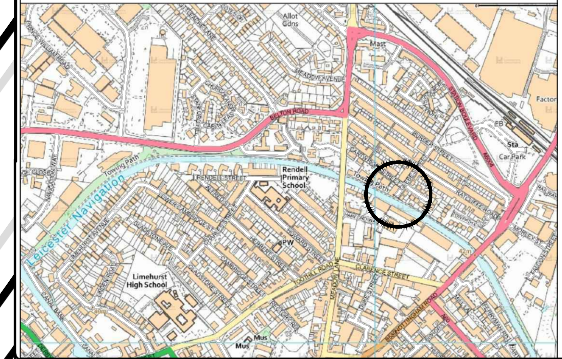

**ENVIRONMENT AND
TRANSPORT DEPARTMENT**

**ANN CARRUTHERS
DIRECTOR**

**TRAFFIC AND SIGNALS
NETWORK MANAGEMENT**

LOUGHBOROUGH

**TITLE:
PROPOSED MANDATORY 24 HOUR
DISABLED PARKING BAY
4 GLEBE STREET**

DRAWING NUMBER		SCALE	
TM5080/T1/1/4GLEBE		NTS	
PREPARED BY:	LEE MEASURES	DATE:	17/01/2023
CHECKED BY:	RIZWAN SHARIF	SIZE :	A4
APPROVED BY:	GAVIN NEAT		

COUNTY HALL * GLENFIELD * LEICESTER * LE3 8ST

Tel:0116 3050001 * Fax: 0116 3050006

E-Mail address:	customerservices@leics.gov.uk
Website:	www.leicestershire.gov.uk



MAPINFO (C) Leicestershire County Council
© Crown copyright. All rights reserved. Leicestershire County Council 100019271
Published 2023.



KEY

RESIDENTS PERMIT
HOLDER PARKING ZONE 6
OR LIMITED WAITING FOR
1 HOUR NO RETURN
WITHIN 1 HOUR MON - SAT
8AM TO 6PM
REVOCATION OF EXISTING
MANDATORY DISABLED
PERSONS PARKING BAY

EXISTING RESTRICTIONS

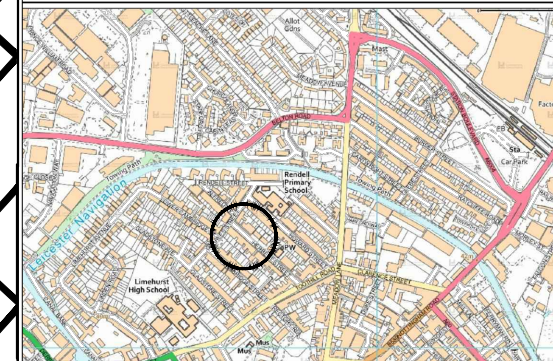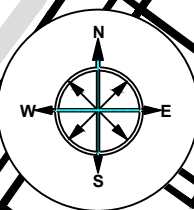

ENVIRONMENT AND
TRANSPORT DEPARTMENT

ANN CARRUTHERS
DIRECTOR

TRAFFIC AND SIGNALS
NETWORK MANAGEMENT

LOUGHBOROUGH

TITLE:

REVOCATION OF MANDATORY 24 HOUR
DISABLED PARKING BAY
71 HERBERT STREET

DRAWING NUMBER

SCALE

TM5080/T1/1/HERBERT

NTS

PREPARED BY: LEE MEASURES

CHECKED BY: RIZWAN SHARIF

APPROVED BY: GAVIN NEAT

DATE: 17/01/2023

SIZE: A4

COUNTY HALL * GLENFIELD * LEICESTER * LE3 8ST

Tel: 0116 3050001 * Fax: 0116 3050006

E-Mail address: customerservices@leics.gov.uk

Website: www.leicestershire.gov.uk

MAPINFO (C) Leicestershire County Council



© Crown copyright. All rights reserved. Leicestershire County Council 100019271
Published 2022.



KEY

RESIDENTS PERMIT
HOLDER PARKING ZONE 6
OR LIMITED WAITING FOR
1 HOUR NO RETURN
WITHIN 1 HOUR MON - SAT
8AM TO 6PM
REVOCATION OF EXISTING
MANDATORY DISABLED
PERSONS PARKING BAY

EXISTING RESTRICTIONS

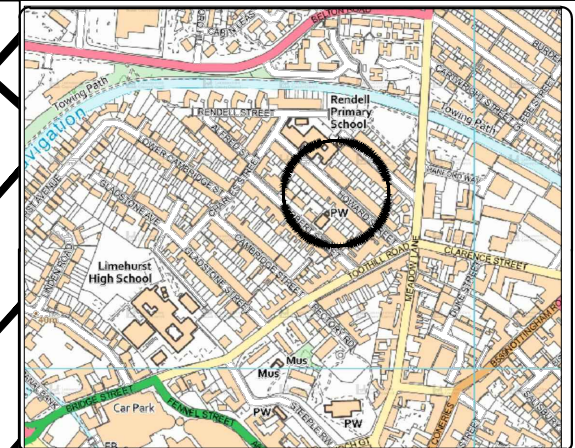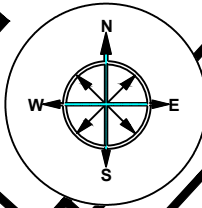

ENVIRONMENT AND
TRANSPORT DEPARTMENT

ANN CARRUTHERS
DIRECTOR

TRAFFIC AND SIGNALS
NETWORK MANAGEMENT

LOUGHBOROUGH

TITLE:

REVOCATION OF MANDATORY 24 HOUR
DISABLED PARKING BAY
42 AND 53 HOWARD STREET

DRAWING NUMBER

SCALE

TM5080/T11/1/42&53HOWARD

NTS

PREPARED BY: LEE MEASURES

CHECKED BY: RIZWAN SHARIF

DATE: 17/01/2023

APPROVED BY: GAVIN NEAT

SIZE: A4

COUNTY HALL * GLENFIELD * LEICESTER * LE3 8ST

Tel: 0116 3050001 * Fax: 0116 3050006

E-Mail address: customerservices@leics.gov.uk

Website: www.leicestershire.gov.uk




MAPINFO (C) Leicestershire County Council



© Crown copyright. All rights reserved. Leicestershire County Council 100019271
Published 2023.



Leicestershire
County Council

KEY

-  RESIDENTS PERMIT HOLDER PARKING ZONE 6 OR LIMITED WAITING FOR 1 HOUR NO RETURN WITHIN 1 HOUR MON - SAT 8AM TO 6PM REVOCATION OF EXISTING MANDATORY DISABLED PERSONS PARKING BAY
-  EXISTING MANDATORY DISABLED PERSONS PARKING BAY
-  OTHER EXISTING RESTRICTIONS

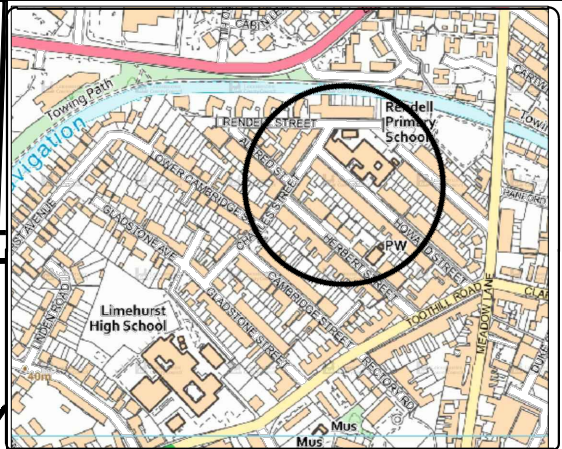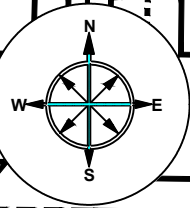

**ENVIRONMENT AND
TRANSPORT DEPARTMENT**

**ANN CARRUTHERS
DIRECTOR**

**TRAFFIC AND SIGNALS
NETWORK MANAGEMENT**

LOUGHBOROUGH

TITLE:
**REVOCATION OF MANDATORY 24 HOUR
DISABLED PARKING BAY
84 HOWARD STREET**

DRAWING NUMBER		SCALE	
TM5080/T1/1/84HOWARD		NTS	
PREPARED BY:	LEE MEASURES	DATE:	17/01/2023
CHECKED BY:	RIZWAN SHARIF	SIZE :	A4
APPROVED BY:	GAVIN NEAT		

COUNTY HALL * GLENFIELD * LEICESTER * LE3 8ST

Tel:0116 3050001 * Fax: 0116 3050006

E-Mail address:	customerservices@leics.gov.uk
Website:	www.leicestershire.gov.uk

MAPINFO (C) Leicestershire County Council
© Crown copyright. All rights reserved. Leicestershire County Council 100019271
Published 2023.



KEY


PROPOSED MANDATORY
DISABLED PERSONS
PARKING BAY

EXISTING RESIDENTS
ZONE 6 PERMIT HOLDER
PARKING ONLY

EXISTING RESTRICTIONS




Leicestershire
County Council

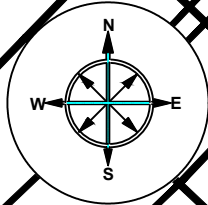

LIMEHURST AVENUE

LINDEN ROAD

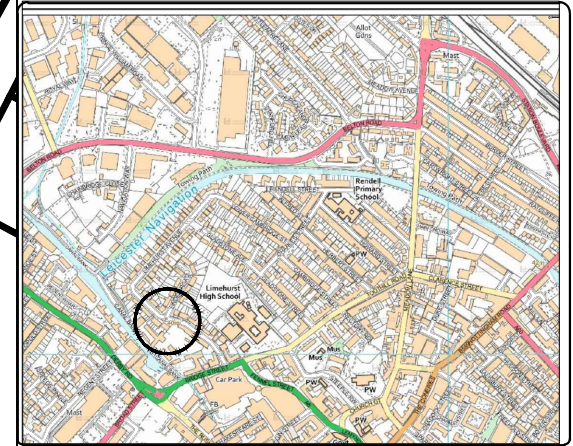

Leicestershire
County Council

ENVIRONMENT AND
TRANSPORT DEPARTMENT

ANN CARRUTHERS
DIRECTOR

TRAFFIC AND SIGNALS
NETWORK MANAGEMENT

LOUGHBOROUGH

TITLE:

PROPOSED MANDATORY 24 HOUR
DISABLED PARKING BAY
18 LIMEHURST AVENUE

DRAWING NUMBER

TM5080/T1/1/18LIMEHURST

PREPARED BY:

LEE MEASURES

CHECKED BY:

RIZWAN SHARIF

APPROVED BY:

GAVIN NEAT

SCALE

NTS

DATE: 17/01/2023

SIZE : A4

COUNTY HALL * GLENFIELD * LEICESTER * LE3 8ST

Tel:0116 3050001 * Fax: 0116 3050006

E-Mail address:

customerservices@leics.gov.uk

Website:

www.leicestershire.gov.uk

MAPINFO (C) Leicestershire County Council


© Crown copyright. All rights reserved. Leicestershire County Council 100019271
Published 2023.

KEY

PROPOSED MANDATORY
DISABLED PERSONS
PARKING BAY

EXISTING RESIDENTS
PERMIT HOLDER PARKING
ZONE 8 OR LIMITED
WAITING FOR 1 HOUR NO
RETURN WITHIN 1 HOUR
MON - SAT 8AM TO 6PM


EXISTING RESTRICTIONS

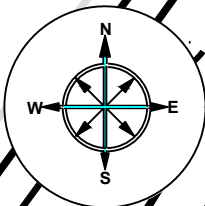

RATCLIFFE ROAD

MAPINFO (C) Leicestershire County Council

© Crown copyright. All rights reserved. Leicestershire County Council 100019271
Published 2023.

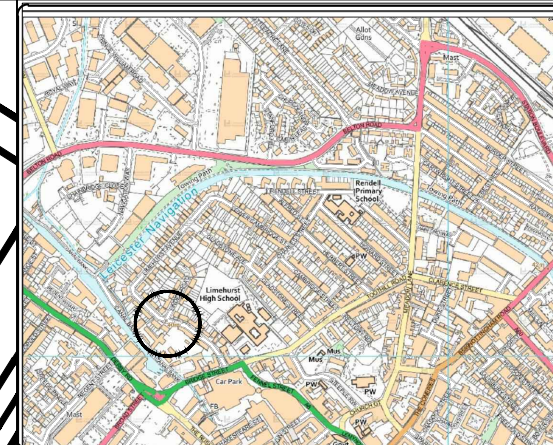

ENVIRONMENT AND
TRANSPORT DEPARTMENT

ANN CARRUTHERS
DIRECTOR

TRAFFIC AND SIGNALS
NETWORK MANAGEMENT

LOUGHBOROUGH

TITLE:

MANDATORY 24 HOUR
DISABLED PERSONS PARKING BAY
87 RATCLIFFE ROAD

DRAWING NUMBER

TM50801/T1/1/87RATCLIFFE

PREPARED BY:

LEE MEASURES

CHECKED BY:

RIZWAN SHARIF

APPROVED BY:

GAVIN NEAT

SCALE

NTS

DATE: 16/11/2022

SIZE: A4

COUNTY HALL * GLENFIELD * LEICESTER * LE3 8ST

Tel: 0116 3050001 * Fax: 0116 3050006



E-Mail address:

customerservices@leics.gov.uk


Website:

www.leicestershire.gov.uk

KEY

 LIMITED WAITING FOR 2 HOURS NO RETURN WITHIN 1 HOUR MON - SAT 8AM TO 6PM
 REVOCATION OF EXISTING MANDATORY DISABLED PERSONS PARKING BAY

EXISTING WAITING RESTRICTIONS

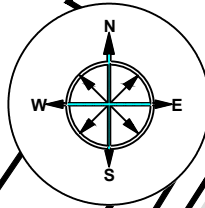

CHAPMAN STREET
CRADOCK STREET

PINFOLD GARDENS

SPARROW HILL



ENVIRONMENT AND
TRANSPORT DEPARTMENT

ANN CARRUTHERS
DIRECTOR

TRAFFIC AND SIGNALS
NETWORK MANAGEMENT

LOUGHBOROUGH

TITLE:

REVOCATION OF MANDATORY 24 HOUR
DISABLED PARKING BAY
33 SPARROW HILL

DRAWING NUMBER

SCALE

TM5080/T1/1/33SPARROW

NTS

PREPARED BY: LEE MEASURES

CHECKED BY: RIZWAN SHARIF

APPROVED BY: GAVIN NEAT

DATE: 17/01/2023

SIZE: A4

COUNTY HALL * GLENFIELD * LEICESTER * LE3 8ST

Tel: 0116 3050001 * Fax: 0116 3050006

E-Mail address:

customerservices@leics.gov.uk


Website:

www.leicestershire.gov.uk



MAPINFO (C) Leicestershire County Council

© Crown copyright. All rights reserved. Leicestershire County Council 100019271
Published 2023.

KEY

 RESIDENTS PERMIT
HOLDER PARKING ZONE 6
OR LIMITED WAITING FOR
1 HOUR NO RETURN
WITHIN 1 HOUR MON - SAT
8AM TO 6PM
REVOCATION OF EXISTING
MANDATORY DISABLED
PERSONS PARKING BAY

 EXISTING RESTRICTIONS

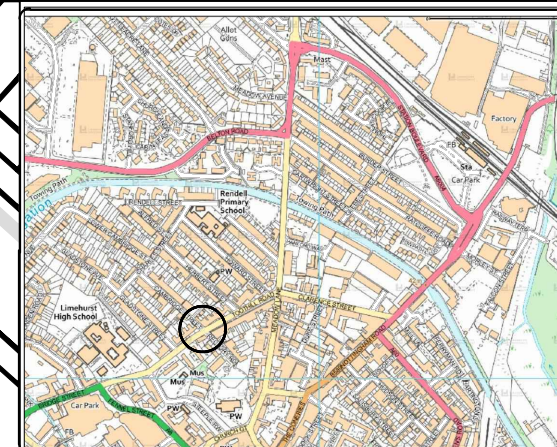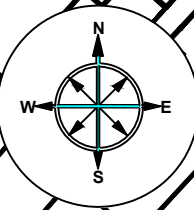

ENVIRONMENT AND
TRANSPORT DEPARTMENT

ANN CARRUTHERS
DIRECTOR

TRAFFIC AND SIGNALS
NETWORK MANAGEMENT

LOUGHBOROUGH

TITLE:

REVOCATION OF MANDATORY 24 HOUR
DISABLED PARKING BAY
CAMBRIDGE STREET

DRAWING NUMBER

SCALE

TM5080/T1/1/CAMBRIDGE

NTS

PREPARED BY: LEE MEASURES

CHECKED BY: RIZWAN SHARIF

APPROVED BY: GAVIN NEAT

DATE: 17/1/2023

SIZE: A4

COUNTY HALL * GLENFIELD * LEICESTER * LE3 8ST

Tel: 0116 3050001 * Fax: 0116 3050006

E-Mail address: customerservices@leics.gov.uk
Website: www.leicestershire.gov.uk

MAPINFO (C) Leicestershire County Council

© Crown copyright. All rights reserved. Leicestershire County Council 100019271
Published 2023.

Statement of Reasons

Proposed Mandatory Disabled Parking Bays

Various Roads, Loughborough

Leicestershire County Council proposes to make the following order.

To add new mandatory disabled parking bays and to remove existing mandatory disabled parking bays. The bays are all situated in residents parking zones except for the one on Sparrow Hill.

The bays being removed are mandatory disabled parking bays that are no longer required. This order proposes to remove these bays, and for them to revert to the restrictions that were in operation before the bay was installed.

These bays are situated outside of:

- 33 Sparrow Hill,
- 71 Herbert Street,
- 42, 53 and 84 Howard Street,
- Cambridge Street near its junction with Toothill Road
- 45 & 63 Cartwright Street, Loughborough

It is proposed to introduce three new mandatory 24 hour disabled persons parking bays that have been requested by residents and who also meet the necessary criteria. These bays are situated outside of:

- 4 Glebe Street,
- 18 Limehurst Avenue
- 87 Ratcliffe Road

The effect of the order is to improve public amenity.

THE LEICESTERSHIRE COUNTY COUNCIL
(LOUGHBOROUGH, CHARNWOOD BOROUGH) CONSOLIDATION ORDER 2022
(VARIOUS ROADS, LOUGHBOROUGH) (AMENDMENT 2) ORDER 202

The Leicestershire County Council ("the Council") in exercise of its powers under Sections 1, 2, 4, 5, 19, 32, 35, 45, 46, 47, 49 and Part IV of Schedule 9 of the Road Traffic Regulation Act 1984 ("the Act") as amended, and of all other enabling powers and after consultation with the Chief Officer of Police in accordance with Part III of Schedule 9 of the Act hereby makes the following Order:-

This Order shall come into operation on <<INSERT DATE>> and may be cited as the The Leicestershire County Council (Loughborough, Charnwood Borough) Consolidation Order 2022 (Various Roads, Loughborough) (Amendment 2) Order 202


1. The "Leicestershire County Council (Loughborough, Charnwood Borough) Consolidation Order 2022" is hereby amended by the plan(s) specified in the First Schedule to this Order and with the inclusion of the plan(s) specified in the Second Schedule, attached hereto.

FIRST SCHEDULE
Plan(s) to be amended


FM82 – Loughborough
FM83 – Loughborough
FM84 – Loughborough
FN81 – Loughborough
FN82 – Loughborough
FP83 – Loughborough


SECOND SCHEDULE
New Plan(s)


FM82 – Loughborough
FM83 – Loughborough
FM84 – Loughborough
FN81 – Loughborough
FN82 – Loughborough
FP83 – Loughborough

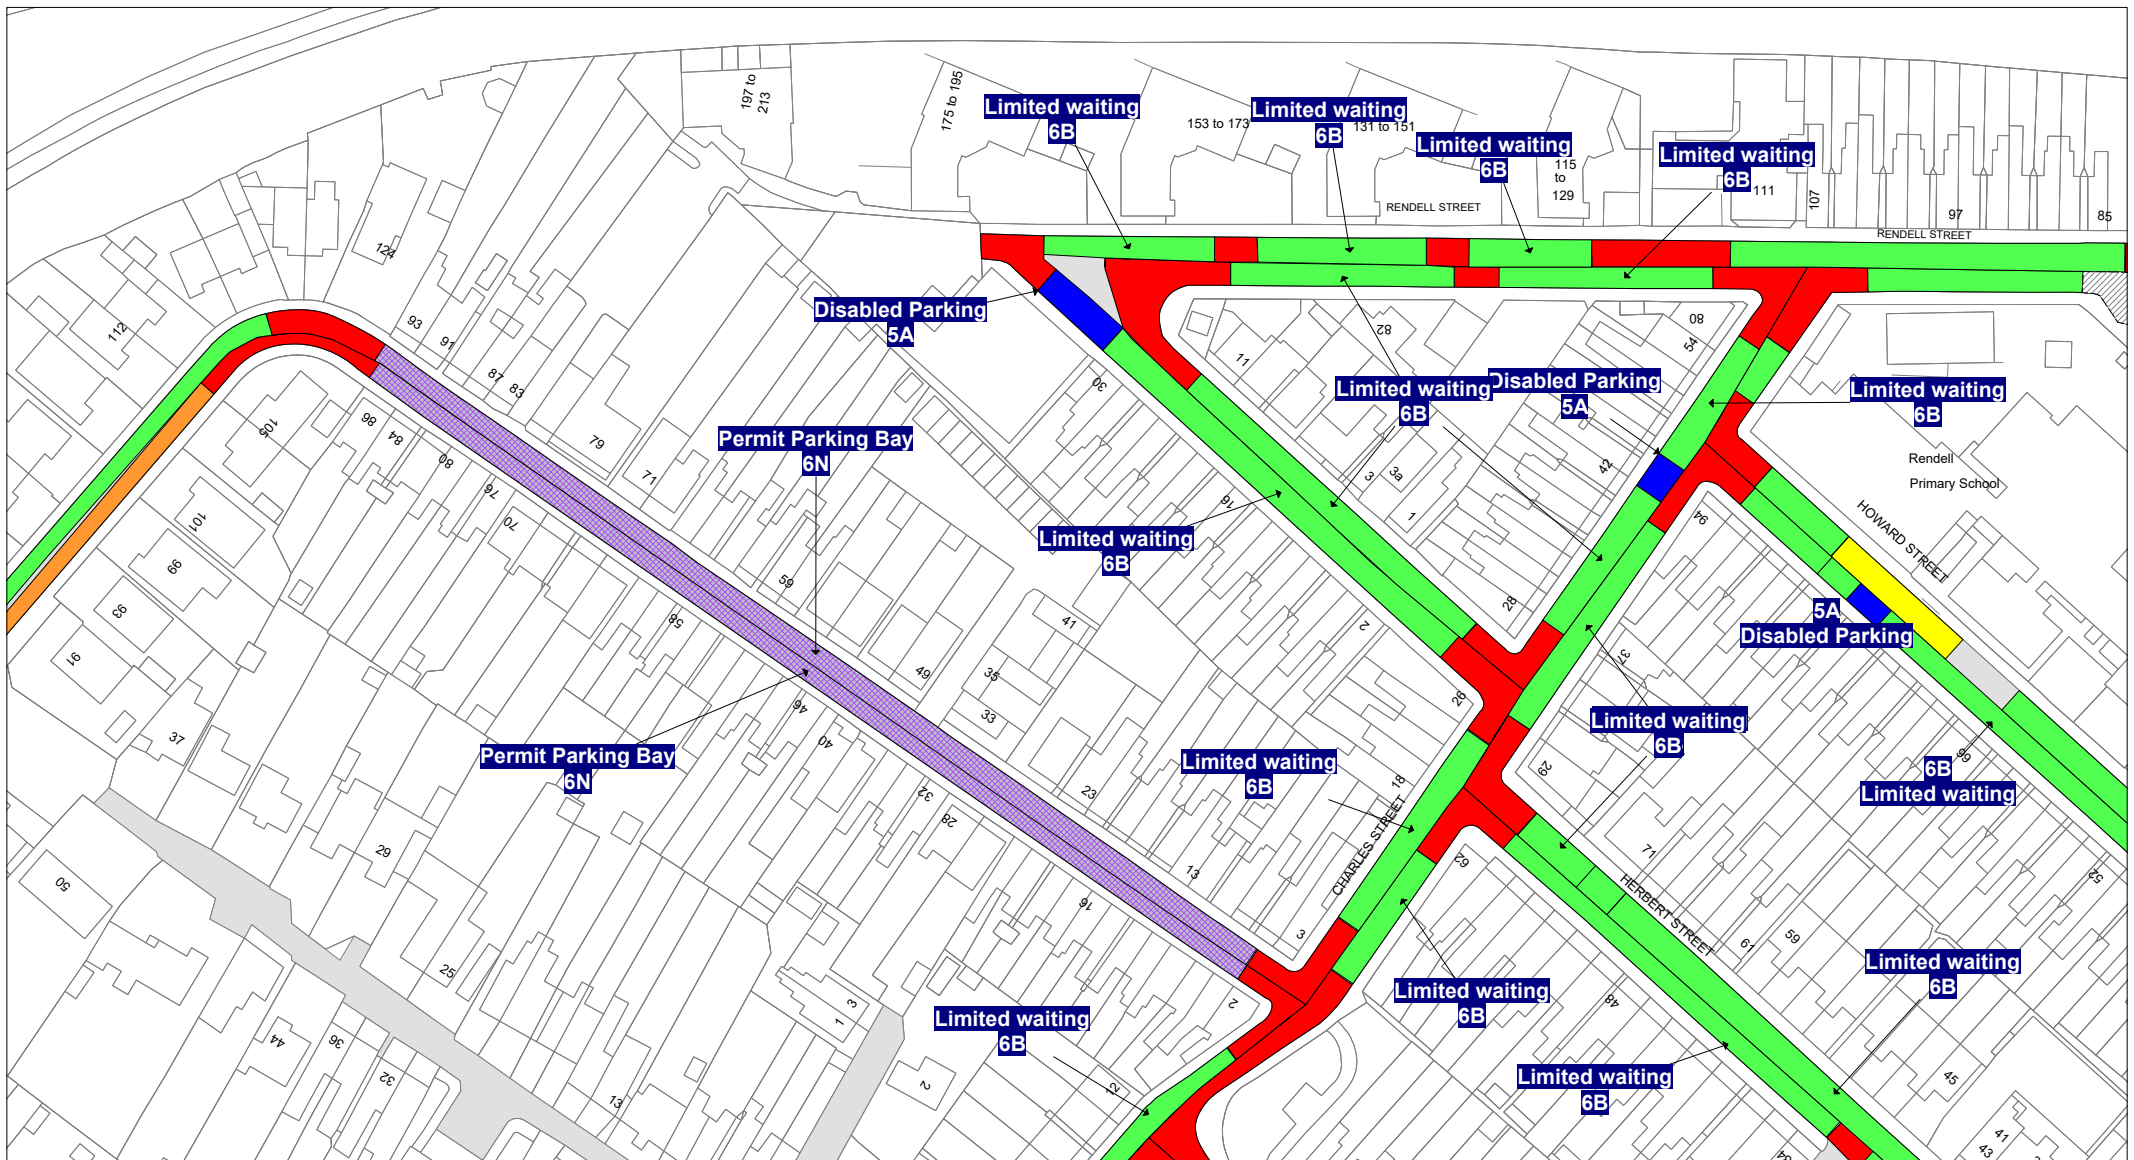



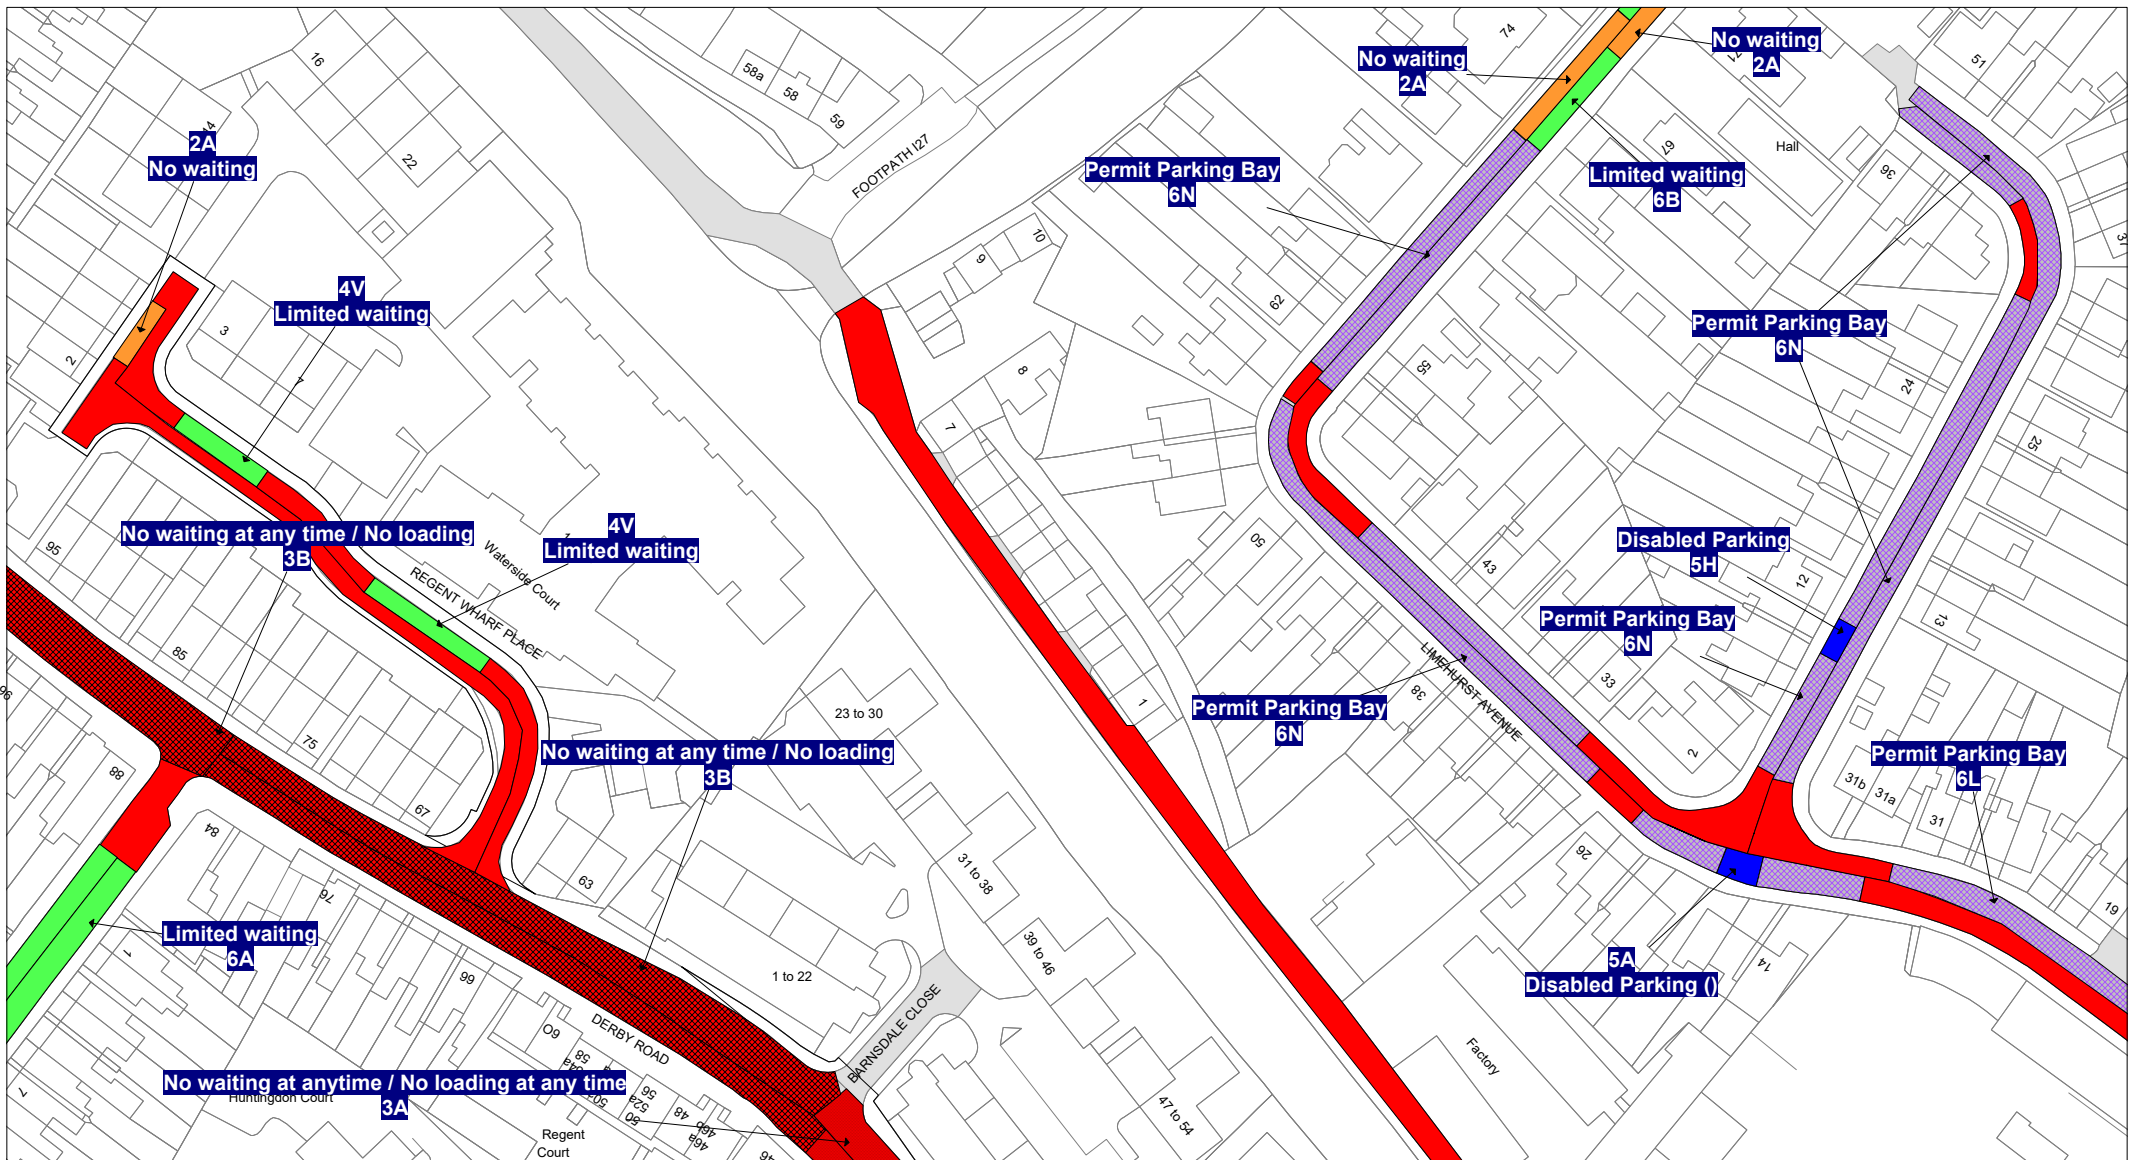

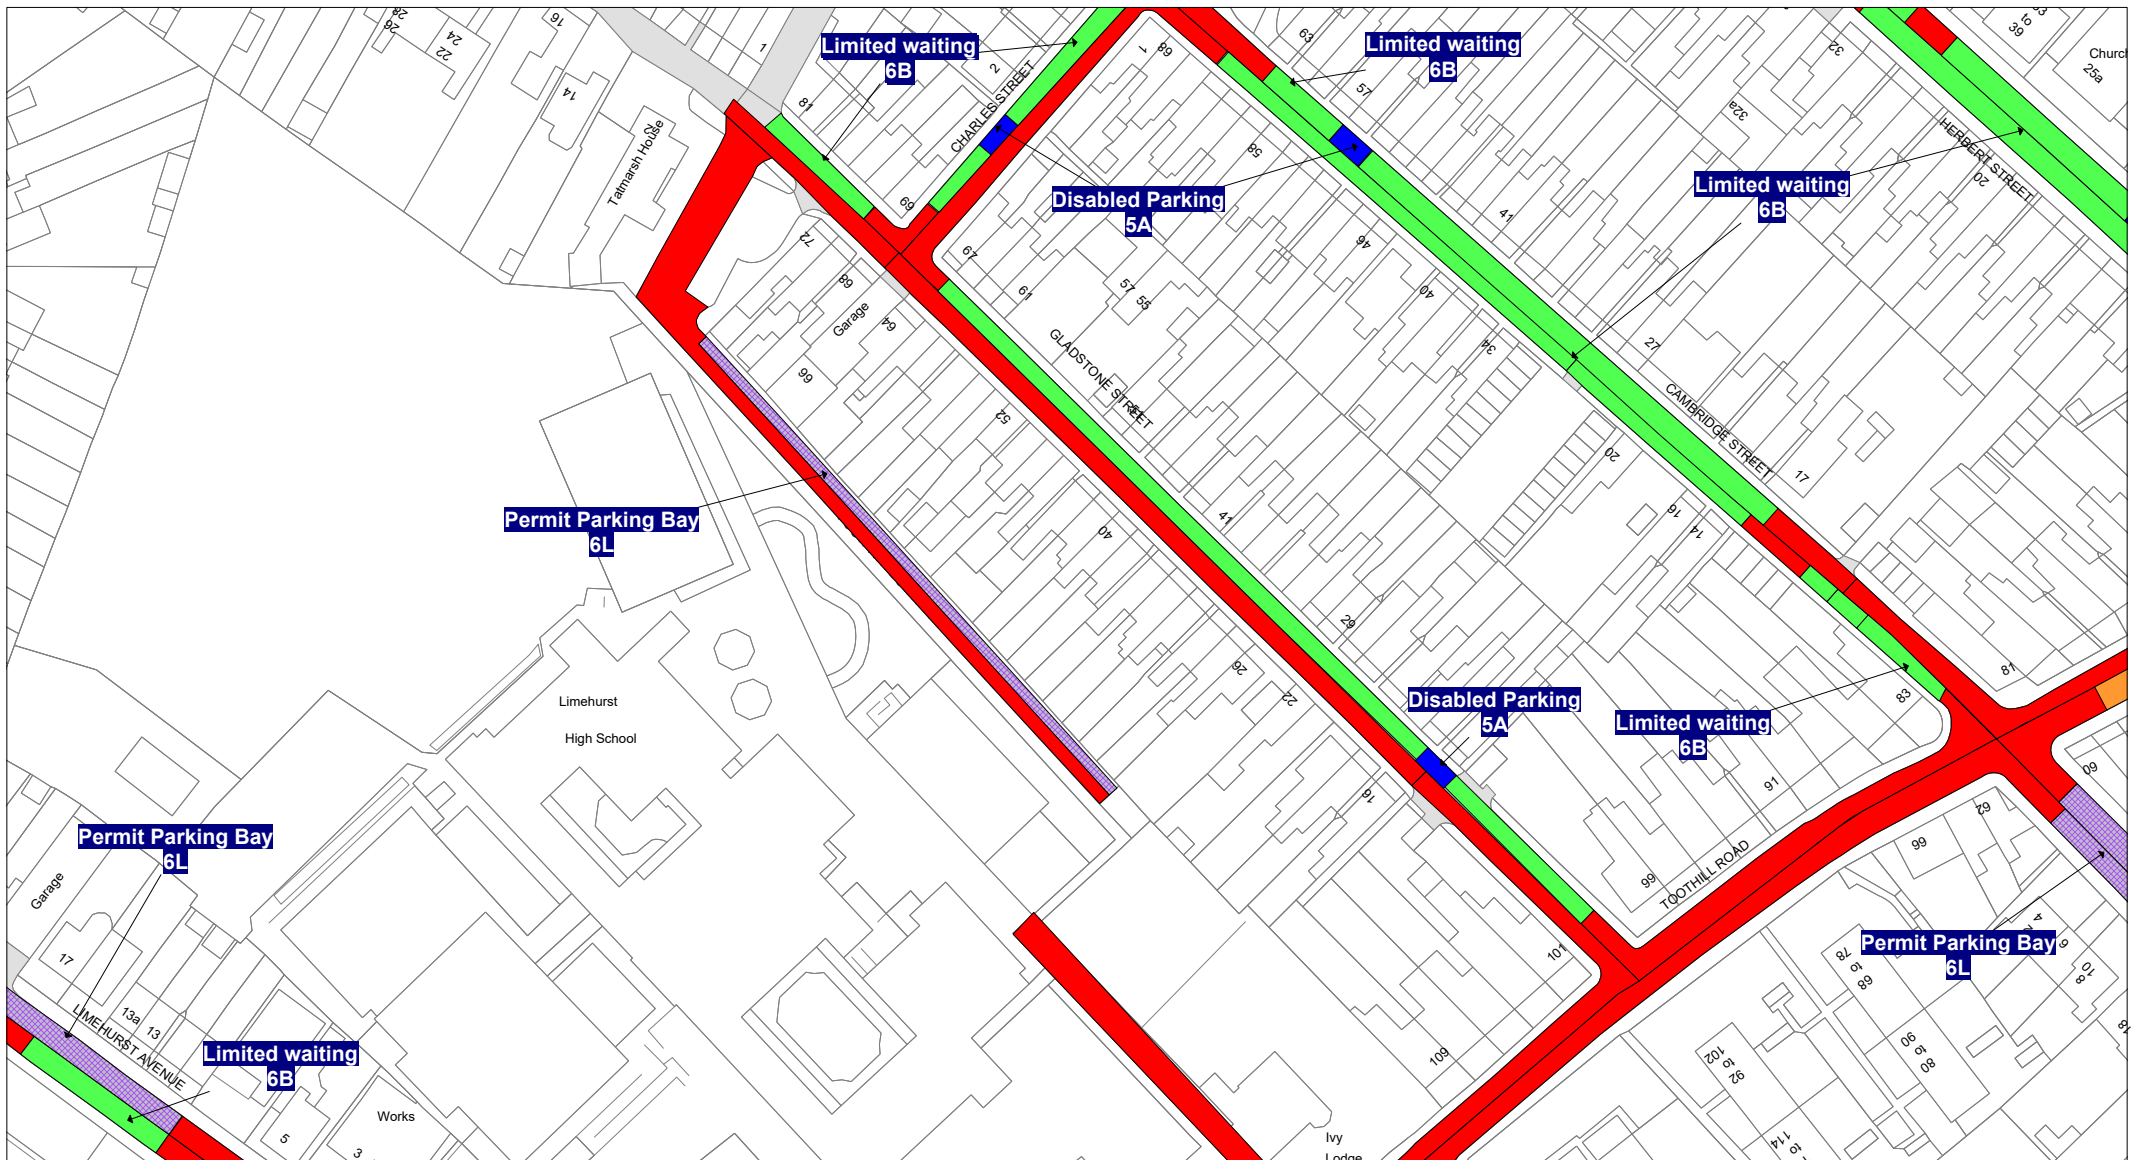

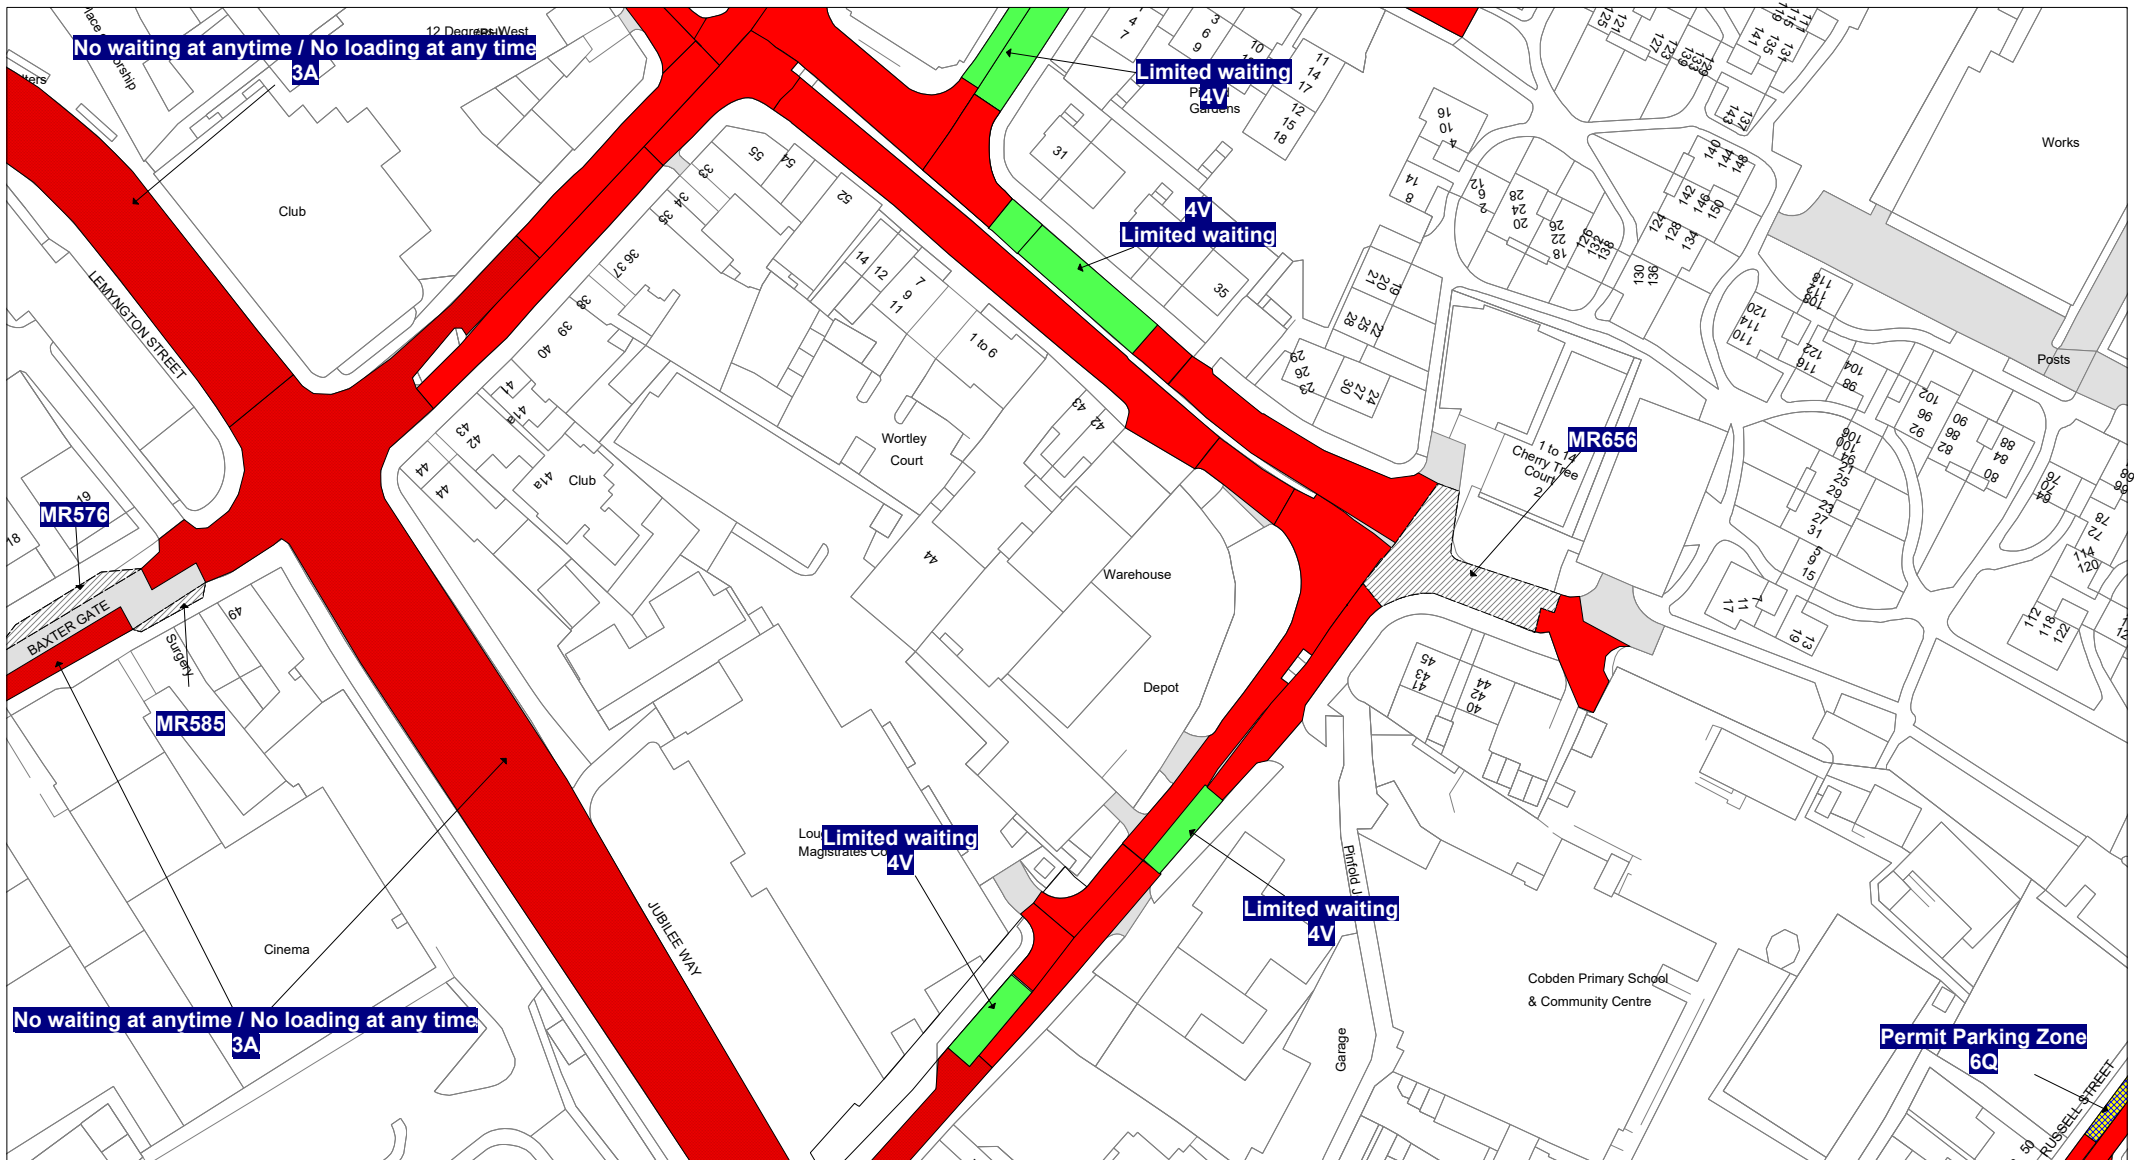

SCALE	1 : 1250
DATE	26/01/2023
DRAWING No.	
DRAWN BY	

MAP LEGEND

DATE: 26/02/2021










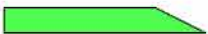











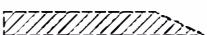


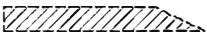

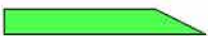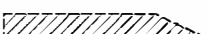

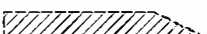



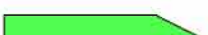



Page
1 of 5

	7A: Ambulance Parking Place		MR585: Loading Only 4pm-midnight and midnight-10am / Disabled Parking 3 hours no return within 1 hour 10am-4pm		6B: Limited waiting 1 hour no return within 1 hour Mon-Sat 8am-6pm except resident's parking permit holders
	7B: Bus Parking Place		MR582: Disabled Parking 3 hours no return within 1 hour Sun - Wed & Fri / No waiting Thurs & Sat		4N: Limited waiting 2 hours no return within 1 hour 8am-6pm
	7C: Bus Parking Place 2 hours no return for 1 hour		MR505: No waiting Thurs / Disabled Parking Fri-Weds 8am-6pm		4L: Limited waiting 2 hours no return within 1 hour Mon-Fri 8am-5pm
	Car Park		4S: Limited waiting 1 hour no return within 1 hour 8am-6pm		4J: Limited waiting 2 hours no return within 1 hour Mon-Fri 8am-6pm
	5A: Disabled Parking		4K: Limited waiting 1 hour no return within 1 hour Fri-Weds 8am-6pm		4X: Limited waiting 2 hours no return within 1 hour Mon-Fri 8am-6pm Partial Footway Parking
	5B: Disabled Parking 3 hours no return within 1 hour		4M: Limited waiting 1 hour no return within 1 hour Mon-Fri 8am-5pm		4Q: Limited waiting 2 hours no return within 1 hour Mon-Fri 9am-5pm
	5J: Disabled Parking 3 hours no return within 1 hour 10am-4pm		4R: Limited waiting 1 hour no return within 1 hour Mon-Fri 8am-6pm		4V: Limited waiting 2 hours no return within 1 hour Mon-Sat 8am-6pm
	5C: Disabled Parking 3 hours no return within 1 hour Mon-Fri 8am-5pm		4H: Limited waiting 1 hour no return within 1 hour Mon-Fri 9am-5pm		6C: Limited waiting 2 hours no return within 1 hour Mon-Sat 8am-6pm 01 Oct - 31 May except resident's parking permit holders
	5D: Disabled Parking 3 hours no return within 1 hour Mon-Sat 8am-6pm		4Y: Limited waiting 1 hour no return within 1 hour Mon-Sat 3pm-6pm		6D: Limited waiting 2 hours no return within 1 hour Mon-Sat 8am-6pm except resident's parking permit holders
	5E: Disabled Parking 3 hours no return within 1 hour Sun - Wed & Fri		4G: Limited waiting 1 hour no return within 1 hour Mon-Sat 8am-6pm		4U: Limited waiting 2 hours no return within 1 hour Mon-Sat 9am-4.30pm
	5K: Disabled Parking 6pm-midnight and midnight-6am		6A: Limited waiting 1 hour no return within 1 hour Mon-Sat 8am-6pm 01 Oct - 31 May except resident's parking permit holders		6E: Limited waiting 20 mins no return within 3 hours Mon-Sat 8am-6pm except resident's parking permit holders
	5F: Disabled Parking Fri-Weds 8am-6pm				
	5G: Disabled Parking Mon-Sat 8am-6pm				
	5H: Disabled Parking Partial Footway Parking				
	MR644: Disabled Parking 6pm-midnight and midnight-6am / Loading Only 6am-6pm				

MAP LEGEND

DATE: 26/02/2021






































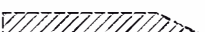
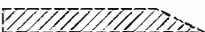
Page
2 of 5

	4Z: Limited waiting 3 hours no return within 1 hour Mon-Fri 10am-3pm		MR616: Limited waiting 1 hour no return within 1 hour Mon-Sat 3pm-6pm / Goods vehicles loading only 30 minutes no return for 30 mins Mon-Sat 9am-3pm		7D: Goods vehicles loading only 6am-6pm
	4C: Limited waiting 30 mins no return within 1 hour 8am-6pm		MR623: Loading Only 30 minutes no return for 30 minutes Mon-Sat 9am-3pm / Limited waiting 1 hour no return within 1 hour Mon-Sat 3pm-6pm		7E: Goods vehicles loading only Mon-Sat 6am-6pm
	4A: Limited waiting 30 mins no return within 1 hour Mon-Fri 8am-6pm		MR506: Limited waiting 1 hour no return within 1 hour Fri-Weds 8am-6pm / No waiting Thurs		7F: Goods vehicles loading only Mon-Sat 8am-6pm
	6F: Limited waiting 30 mins no return within 1 hour Mon-Fri 9am-4pm except resident's parking permit holders		MR658: No waiting 3pm-midnight and midnight-10am / Limited waiting 3 hours no return within 1 hour Mon-Fri 10am-3pm		7G: Loading Only 30 mins no return for 1 hour Mon-Sat 8am-6pm
	4B: Limited waiting 30 mins no return within 1 hour Mon-Sat 8am-6pm		MR563: Limited waiting 2 hours no return within 1 hour Mon-Sat 9am-4.30pm / No waiting / No Loading Mon-Sat 7.30am-9am and 4.30pm-6pm		7H: Loading Only 30 minutes no return for 30 minutes 6am-6pm
	4WA: Limited waiting 30 mins no return within 1 hour Mon-Sat 8am-6pm Partial Footway Parking		MR664: Limited waiting 1 hour no return within 1 hour Mon-Sat 8am-6pm / Residents Permit Holders Only		7J: Loading Only 30 minutes no return for 30 minutes 8am-6pm
	4T: Limited waiting 30 mins no return within 30 mins Mon-Sat 8am-6pm		MR669: Limited waiting 2 hours no return within 1 hour Mon-Sat 8am-6pm / Residents Permit Holders Only		7Z: Loading Only 30 minutes no return for 30 minutes Mon-Sat 9am-3pm
	4W: Limited waiting 30 mins no return within 30 mins Mon-Sat 8am-6pm Partial Footway Parking		MR610: Limited waiting 1 hour no return within 1 hour Mon-Sat 8am-6pm / No stopping except taxis 6pm-midnight and midnight-8am		7K: Loading Only 4pm-midnight and midnight-10am
	4P: Limited waiting 4 hours no return for 12 hours		Loading Bay		7L: Loading Only 5am-8am
	4F: Limited waiting 40 mins no return within 1 hour Mon-Sat 8am-6pm		7W: Goods vehicles loading only 30 minutes no return for 30 mins Mon-Sat 9am-3pm		7M: Loading Only 6am-6pm
	4D: Limited waiting 40 mins no return within 20 mins				7N: Loading Only at any time
	4E: Limited waiting 40 mins no return within 20 mins Mon-Sat 8am-6pm				7P: Loading Only Mon-Fri 10am-4pm
					7Q: Loading Only Mon-Sat 8am-6pm
					MR607: Loading Only Mon-Fri 10am-4pm / No waiting / No Loading Mon-Fri midnight-10am and 4pm-midnight and S Sun

MAP LEGEND

DATE: 26/02/2021








































Page
3 of 5


	MR625: Loading Only 30 minutes no return for 30 minutes 6am-6pm / No stopping except taxis 6pm-midnight and midnight-6am		2J: No waiting Mon-Fri 7.30am-9am and 4.30pm-6pm		MR659: No waiting Mon-Fri 8am-6pm / School keep clear Mon-Fri 8am-4pm
	MR608: No stopping except taxis 6pm-midnight and midnight-6am / Goods vehicles loading only 6am-6pm		2B: No waiting Mon-Fri 8am-5pm		MR661: School keep clear Mon-Fri 8am-5pm / No waiting Mon-Sat 8am-6pm
	MR576: No stopping except taxis 6pm-midnight and midnight-6am / Loading Only 6am-6pm		2U: No waiting Mon-Fri 8am-9am and 2pm-4pm between 01 Sept and 15 Dec and 01 Jan and 15 July except for bank holidays		1A: No waiting at any time
	MR602: No stopping except taxis 6pm-midnight and midnight-8am / Goods vehicles loading only Mon-Sat 8am-6pm		2H: No waiting Mon-Fri 9am-5pm		3D: No waiting at any time / No loading 7pm-midnight and midnight-7am
	MR579: No stopping except taxis 8am-midnight and midnight-5am / Loading Only 5am-8am		2F: No waiting Mon-Sat 6am-6pm		3C: No waiting at any time / No loading Mon-Fri 7.30am-9am and 4.30pm-6pm
	1C: No stopping at any time		2K: No waiting Mon-Sat 7.30am-9am and 4.30pm-6pm		3E: No waiting at any time / No loading Mon-Sat 10am-4pm
	No waiting		2A: No waiting Mon-Sat 8am-6pm		3K: No waiting at any time / No loading Mon-Sat 7.30am-9am
	2V: No waiting 3pm-midnight and midnight-10am		2M: No waiting Thurs		3B: No waiting at any time / No loading Mon-Sat 7.30am-9am and 4.30pm-6pm
	2C: No waiting 8am-6pm		2L: No waiting Thurs & Sat		3F: No waiting at any time / No loading Tues & Fri
	2N: No waiting by any heavy goods vehicles over 7.5t 7pm-midnight and midnight-7am		2E: No waiting Tues 8am-6pm		3A: No waiting at anytime / No loading at any time
	2R: No waiting by buses Mon-Fri 9am-5pm		3H: No waiting / No Loading Mon-Fri midnight-10am and 4pm-midnight and Sat & Sun		MR660: No waiting at any time / School keep clear Mon-Fri 8am-5pm
	2P: No waiting Mon-Fri 10am-4pm		3J: No waiting / No Loading Mon-Sat 7.30am-9am		MR656: School keep clear Mon-Fri 8am-4pm / No waiting at any time
	2G: No waiting Mon-Fri 7.30am-9am and 3pm-6pm		3G: No waiting / No Loading Mon-Sat 7.30am-9am and 4.30pm-6pm		
			MR587: Residents Permit Holders Only midnight-8am and 6pm-midnight and Sun / No waiting Mon-Sat 8am-6pm		

MAP LEGEND

DATE: 26/02/2021

Page
4 of 5

	9A: Parking Place		PED9: Pedestrian Zone (Except for loading & access (midnight - 10am & 4pm - midnight))		6P: Workplace Parking Zone Mon-Fri
	9D: Parking Place Footway Parking		PED8: Pedestrian Zone (Except for loading (midnight - 10am & 4pm - midnight))		Restricted Parking Zone
	9C: Parking Place Partial Footway Parking		PED7: Pedestrian Zone (Except for loading by permit holders (midnight - 10am & 4pm - midnight))		2W: Restricted Parking Zone (No waiting and Loading at anytime)
	9B: Parking Place Solo Motorcycles		PED10: Pedestrian Zone (Except for loading)		2Q: Restricted Parking Zone (No waiting at anytime)
	Pedestrian Zone		PED4: Pedestrian Zone Sun - Wed & Fri 10am-4pm and Thurs & Sat 2am-8pm		2S: Restricted Parking Zone Mon-Fri 8am-9am and 2pm-4pm
	PED2: Pedestrian & Cycle Zone		6L: Residents Permit Holders Only		2T: Restricted Parking Zone Mon-Fri 8am-9am and 2pm-4pm 01 Sep - 15 Dec and Mon-Fri 8am-9am and 2pm-4pm 01 Jan 15 Jul Except bank holidays
	PED1: Pedestrian & Cycle Zone (Except for access to off street premises)		6M: Residents Permit Holders Only midnight-8am and 6pm-midnight and Sun		8A: School keep clear
	PED6: Pedestrian & Cycle Zone (Except for loading (midnight - 10am & 4pm - midnight))		6N: Residents Permit Holders Only Partial Footway Parking		8C: School keep clear Mon-Fri 8am-4pm
	PED3: Pedestrian & Cycle Zone (Except for loading)		6Q: Residents Parking Zone		8B: School keep clear Mon-Fri 8am-5pm
	PED12: Pedestrian & Cycle Zone Except for loading (Sun-Wed midnight-10am,4pm-midnight & Thurs-Sat midnight-4am,8pm-midnight		6G: Residents Parking Zone (In marked bays)		7R: No stopping except taxis
	PED5: Pedestrian & Cycle Zone Sun - Wed & Fri midnight-10am and 4pm-midnight and Thurs & Sat midnight-2am and 8pm-midnight (Except for loading)		6H: Residents Parking Zone Mon-Fri		7S: No stopping except taxis 6pm-midnight and midnight-6am
	MR593: Pedestrian & Cycle Zone Sun - Wed & Fri midnight-10am and 4pm-midnight and Thurs & Sat midnight-2am and 8pm-midnight (Except for loading) / Pedestrian Zone Sun - Wed & Fri 10am-4pm and Thurs & Sat 2am-8pm		6J: Residents Parking Zone Mon-Sat 8am-6pm		7T: No stopping except taxis 6pm-midnight and midnight-8am
			6K: Residents Parking Zone Mon-Sat 8am-6pm 01 Oct - 31 May		7U: No stopping except taxis 8am-midnight and midnight-5am
					7A1: No stopping except taxis 8pm-midnight and midnight-6am

 **7V:** No stopping except taxis 9pm-midnight and
midnight-2am **7X:** No stopping except taxis midnight-5am